

SW258
10/01

WELL COMPLETION REPORT

Date(s) 7/30/02 County Hampshire Permit #: DW-14-02-353

Town: _____ Area Name/Location _____

Well Owner: Derek Shreve

Telephone Number: 822-8501

Well Driller: B. Nash Smith

Telephone Number: 822-4786

Address: HC 65 Box 4280

Romney, NY 26757

Address: HC 88' Box 2-A

Springfield WV 26763

WELL LOG

DEPTH IN FEET	FORMATIONS: KIND, THICKNESS, AND IF WATER BEARING	REMARKS:
0-25	Yellow shale	Type of Well: <u>home</u> Drilling Method: <u>air-spinner</u>
26-45	Red shale	Well Diameter: <u>6 1/8"</u> Casing O.D.: <u>6 5/8"</u>
46-64	hard gray shale	Well Depth: <u>140'</u> Date Completed: <u>7/30/62</u>
65-	fractured water bearing	CASING: Length <u>60</u> Feet Height above ground <u>1</u> Feet
66-117	hard red + gray shale	☒ Steel ☐ Plastic ☐ Cast Iron
118-120	fractured water bearing	Other _____
121-140	hard red sandstone	Type _____
		SCREEN
		☐ None Installed
		Type _____ Diameter _____
		Slot/Gauge _____ Length _____
		Set Between _____ Ft. and _____ Ft.
	2100 gph	

PUMPING OR BAILING TEST

DETAILS	#1	#2	#3
Static Water Level (Ft. Below Grade)	38		
Pumping Rate (GPM)	35		
Pumping Level (Ft. Below Grade)	140		
Duration of Test (In Hours)	1		
Recovery Time to Static Level (In Hours)	1/4		

WELL HEAD

Pitless Adapter: Type, Make, Etc.

Weil Cap: Type, Make, Etc.

Well Seal: Type, Make, Etc.

Well Platform:

Length _____ Width _____ Thickness _____

Grouting: ☒ Yes ☐ No


All Public Water Supplies must be grouted.

I hereby certify that this well was drilled and constructed under my supervision, in compliance with all requirements of the referenced permit, and that this record is true to the best of my knowledge and belief.

73 Mark Smith #001
Name
Mark Smith Well Drilling Certification No.
Registered Business Name
Mark Smith 7/30/02
Signed Date

Please draw a sketch of the property showing existing or proposed well with locations, and distance to structures, existing or proposed systems within 200 feet of well location, slope of site and lot dimensions. Locate and show distances to animal pens, barnyards or any other factors which can be a possible source of contamination for the water supply.

☒ House ☒ Water Supply ☒ Percolation Test Site
 --- Soil Absorption Line → Dir. Of Ground Slope --- Property Line
 ||||| Trees ☐ ST Septic Tank ☐ MH Mobile Home

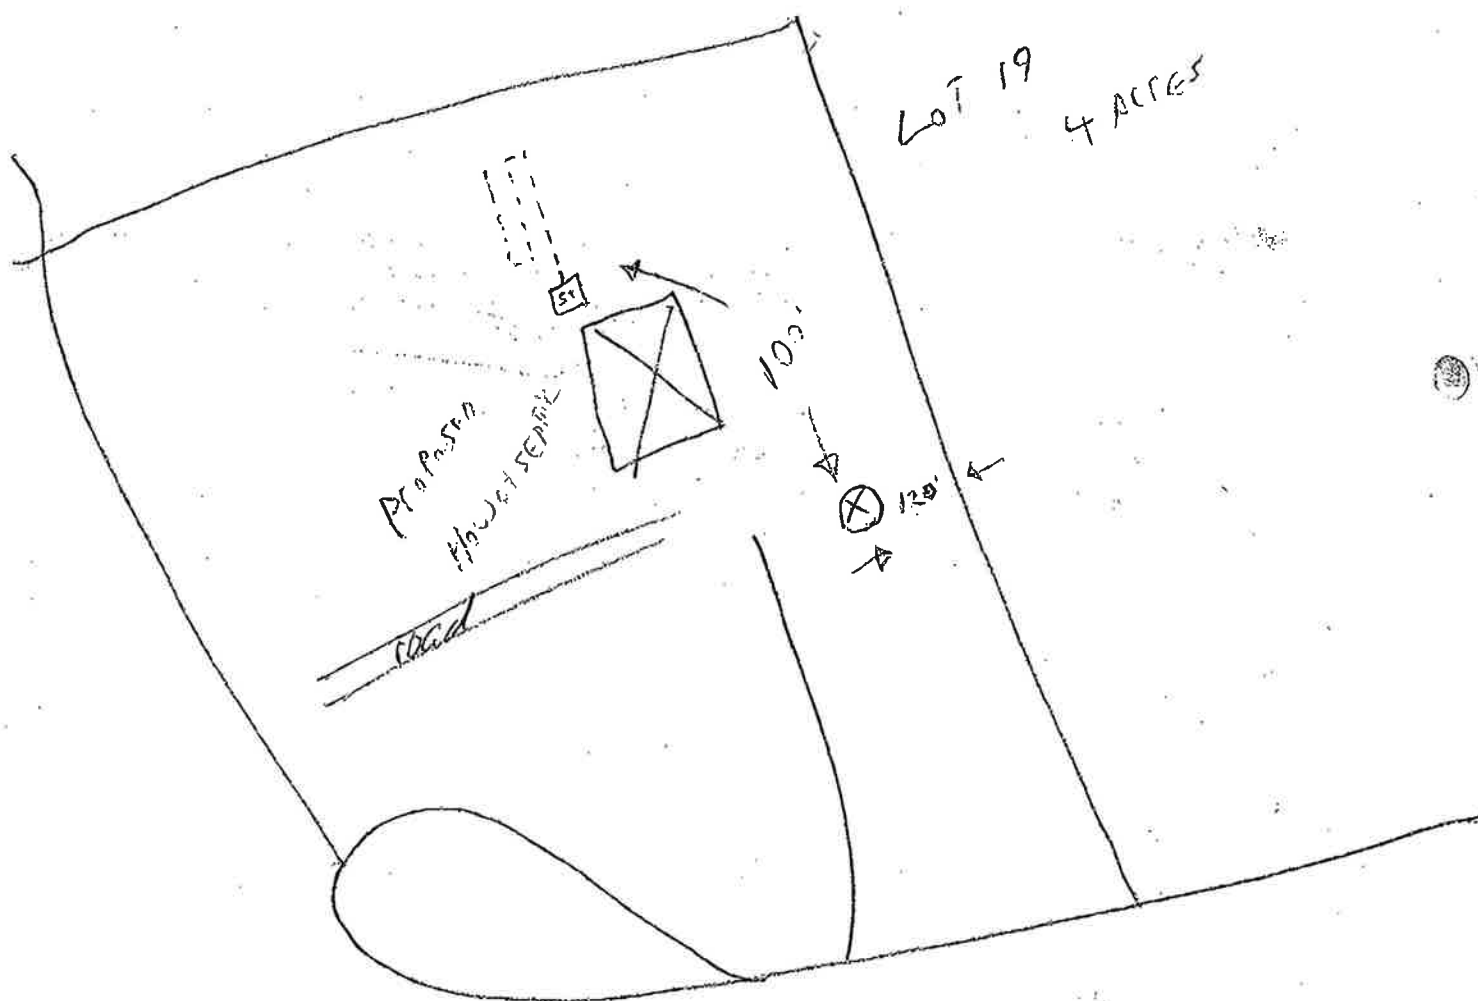

FOR HEALTH DEPARTMENT USE ONLY:

COUNTY: _____

Date Received: 5-17-02

Coordinates: N _____ W _____

Date Evaluated: _____

Reviewed by: _____ Date fee paid: _____

Received From: _____

Permit: ☐ Issued ☐ Denied Permit No.: _____

PRINT:

HEALTH DEPARTMENT

APPLICATION FOR A PERMIT TO INSTALL OR MODIFY A SMALL ON-SITE SEWAGE DISPOSAL SYSTEM

Property Owner: Derek + Renee ShreveCertified Installer: Dave Adams Class: ☐ I ☒ IIAddress: HC 65 Box 4080Address: HC 65 Box 2300 SpringfieldPhone: 492-5866Phone: (home) (304) 822-8801 (business) (443) 994-2792Installer No.: 54-94-A-0221 WV Contractor's No.: WV024136Directions to property: Shady Lane subdivision lot #19 take Rte 50 to McKeeHollow Rd. turn right on Dennis Park Road til road turns to dirt turn left on to

Proposed facility to be served:

(Please provide specific and detailed directions)

☒ Residence, No. of bedrooms: 4 No. of individuals served: 2☐ Other, _____Facility served is: ☒ New ☐ Existing Water Source: _____Property deed recorded in Book No.: 412 Page(s): 596Date the property deed was recorded: March 12, 2002

If lot or tract created after July 1, 1970, please refer to Subdivision box. →

The minimum lot size or area reserved for a sewage disposal system in a subdivision may vary based on the date the subdivision was created.

Subdivision name: Shady Lane Approval number: _____County tax map: 29 Parcel No.: 94Size of Lot: 4 acres square feet / acres

Unless the division of a tract, of lot or parcel results in lots in excess of two acres and in which those lots have an average frontage of 150 feet or more, permits for individual sewage disposal systems shall be withheld until a completed application for the subdivision is approved which indicates that such systems may be expected to comply with applicable design standards on all proposed building lots contained within the original tract.

To the best of my knowledge, the information provided with this application is true and I understand that I am responsible for employing a properly certified and licensed sewage system installer and for informing that installer of the existing or proposed locations of any water sources and property lines. I further understand that it is my responsibility to consult the sanitarian for assistance as necessary and to determine the location of any existing water sources or water supply lines.

(Signature of the owner or authorized agent)

Application is herein made to: ☒ Install ☐ Modify a/an: _____☒ Septic Tank ☒ Absorption Field ☐ Alternate System ☐ Other: _____Soil percolation tests were conducted on April 18, 2002 at a depth of _____ inches.

The time, in minutes, for the final 6 inch drop in each test hole is as follows:

Test Hole:	#1	#2	#3	#4	6 feet hole free of Water and solid rock
Time:	<u>180</u>	<u>169</u>	<u>192</u>	<u>204</u>	☒ Yes ☐ No

Times given for each percolation test hole are to be added together to give a total number of minutes: 31.04then the total shall be divided by 24 in order to give the average time for a one inch drop: 31.04 (minutes per inch).

The undersigned certifies that the percolation test was conducted by the owner, or a certified installer, using approved procedures as outlined in the Design Standards. In the event that the percolation rate has received previous approval in a subdivision application to the health department, the owner's signature shall certify acceptance of the percolation test results for purposes of system design.

Signed: _____, on this date: 4/18/02

Reverse of form must be completed.

Absorption Field: Equivalent to _____ square feet of conventional gravel trench system
☐ Trench System: No. of Lines: _____, Lengths: 100, 100, 100, _____
☐ Gravel Trench Width: 36 inches, or Gravelless Pipe Diameter: 10 inches,
☐ If Chamber System: Manufacturer: ADS, Number of Chambers: _____
☐ Soil absorption bed: Requires an oversizing of bottom surface area by 30%.
 If soil absorption bed, Length: _____ feet by Width: _____ feet, or if Chamber Sys
 Manufacturer: _____, Number of Chambers: _____

Distances (to nearest):

Septic Tank to: Building Foundation: 10 feet, Property Line: 10 feet, Water Supply: 50 feet
 Absorption Field to: Building Foundation: 10 feet, Property Line: 10 feet, Water Supply: 100

Materials:

The installation or modification of all parts of the sewage disposal system, including required materials, shall be done in compliance with applicable design standards issued by the Public Health Sanitation Division, Office of Environmental Health Services, and appropriate manufacturer's recommended procedures and practices.


Signature of Certified Installer or Owner-Installer: Dad Dela

Draw a sketch of the property showing existing or proposed well locations that would be within 200 feet of the proposed on-site sewage system, location of structures, and property line locations.

Sketch of proposed system:

-  Direction of ground slope
-  Percolation test site
-  Property line
-  Residence or facility served
-  Septic Tank
-  Soil absorption lines
-  Trees
-  Water source
-  Water supply line

Show all structures or facilities to be served by on-site sewage system on the lot or tract.

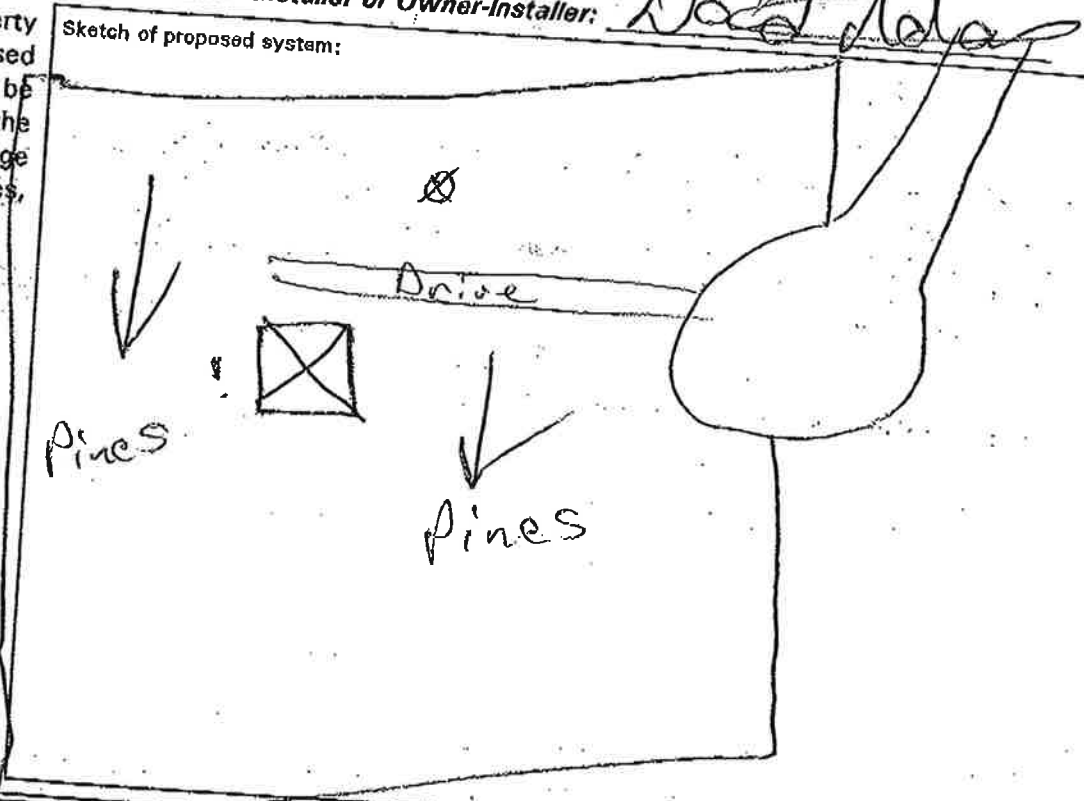

FOR HEALTH DEPARTMENT USE ONLY:

Date Received: 4/22/02

Date Site Evaluated: _____

Received From: _____

COUNTY: _____

Coordinates: N _____ W _____

Reviewed by: _____ Date fee paid: _____

Permit: ☐ Issued ☐ Denied Permit No.: _____