

SS-177

Revised 1-71

WEST VIRGINIA
SEPTIC TANK INSPECTION FORMName of Owner Hampshire Health Department Installation Permit No. ST-14-13-330Address 2008 Bunfoot St. Falls Church, VA 22043Property Address Short Mtn Est. Lot #15

DESCRIPTION & NUMBER OF UNITS SERVED

Type Facility Served cabin No. Water Closets Lot Size 6 ^{acres} sq.-ft. Area suitable for sewage disposal installation sq.ft.Source of Water Supply well No. Lavatories No. Bedrooms (2) No. Showers or Tubs No. Baths No. Garbage Grinders 0 No. Automatic Washers 0

SEPTIC TANK

Material concrete Length x Width x Depth = cubic feetLiquid Depth ft. Liquid Capacity 1000 gal.Distance to: Dwelling 20' Water Supply 100' Nearest Property Line 200'

SOIL ABSORPTION SYSTEM

Type Drain Line Material gravelless Trench Width 24 InchesTrench Depth 24 Inches Total Absorption area in Trench Bottom 480 sq. ft.Diameter of Drain Line 10 Inches Type Filter Media No. of Drain Lines 2 Depth Filter Media Under Drain Line InchesLength of Each Line 80, 80, ft. Depth Filter Media Over Drain Line in.Distance of Disposal Field to: (a) Dwelling 40'(b) Water Supply 100' + (c) Nearest Property Line 140'


An inspection of the septic tank system described herein disclosed that said system (MEETS, DOES NOT MEET) the minimum standards established by the West Virginia State Department of Health.

Date 4-19-83Sanitarian [Signature]

SKETCH OF SYSTEM TO BE DRAWN ON BACK

Note: Copy of this inspection report must be given to owner and the original filed in the Health Department files. PERMANENT RECORD - DO NOT DESTROY.

Please draw a sketch of the property showing existing or proposed well location, location of structures, existing or proposed sewage systems within 200 feet of well location, slope of site and lot dimensions. Locate animal pens, barnyards or any other factors which can be a possible source of contamination for the water supply.

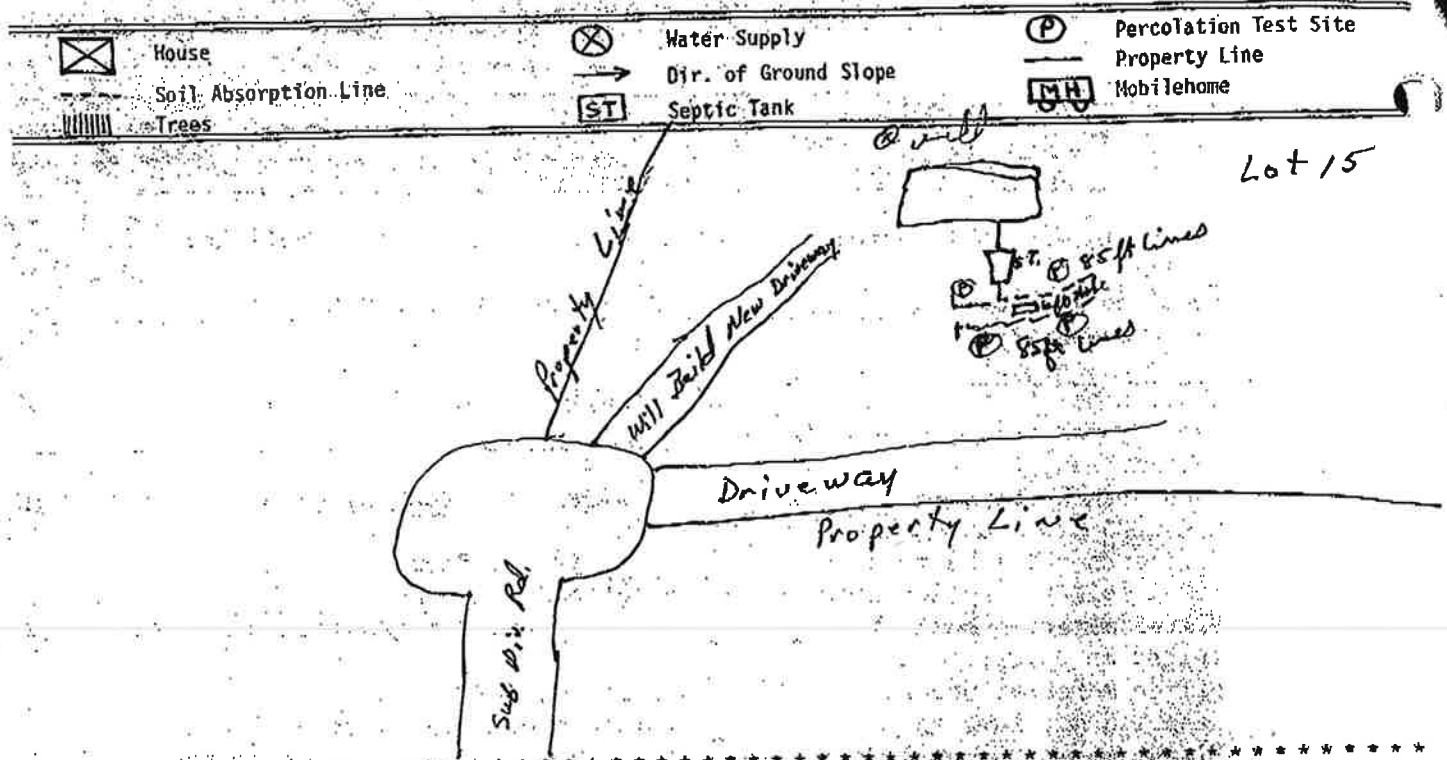

PART III SEWAGE DISPOSAL SYSTEM INFORMATION

☒ Install ☐ Modify
☒ Septic Tank ☒ Absorption Field ☐ Holding Tank ☐ Pit Privy ☐ Vault Privy
☐ Chemical/Composting Toilet ☐ Alternate System (attach detailed plans)
 Other _____

DESCRIPTION OF PROPOSED SYSTEM:

Septic Tank: Capacity 1000 Gal Material Concrete Nearest Prop. Line 90ft
 Absorption Field: 536 Sq. ft. with 2 lines and 85 long
 Pipe ASTM No. 9727 PVC Nearest Property Line 80ft
 Type of Water Supply: 100ft Area Suitable for Absorption Field: 536 Sq. ft.

Six-foot hole free of water or solid rock? ☒ Yes ☐ No

PERCOLATION TEST:

TEST HOLE: #1 #2 #3 #4
45 minutes 90 minutes 120 minutes 120 minutes

Total minutes 375, divided by 24 = 15 minutes average time for water to fall one inch.

Test done on 3-31-97 (date) using approved procedures outlined in the Design Standards.

Signed: Billy A. Hart

Billy A. Hart
 Signature of Installer

54-87-6270
 Certification No.

3-31-97
 Date

WV STATE DEPARTMENT OF HEALTH
Office of Environmental Health Services
ENVIRONMENTAL ENGINEERING DIVISION

SW258

WELL COMPLETION REPORT

Date(s) 5/7/93 County Hampshire Permit #: DW-14-04-93-226
Town: _____ Area Name/Location Short Mt. ~~Easton~~ Lot 15
Well Owner: Harold Belt Address: 2008 Burfoot St.
Telephone Number: 713-893-7428 Falls Church Va. 22043
Well Driller: B. Mark Smith Address: HC 86 Box 2-A
Telephone Number: 822-4786 / 822-5867 Springfield WV. 26763

WELL LOG

DEPTH IN FEET	FORMATIONS: KIND, THICKNESS, AND IF WATER BEARING	REMARKS:
0-14	Soft Shale	Type of Well: <u>home</u> Drilling Method: <u>Air-hammer</u>
15-131	hard red Sandrock	Well Diameter: <u>6 1/4"</u> Casing O.D.: <u>6 5/8"</u>
132-139	hard brown Shale	Well Depth: <u>285</u> Date Completed: <u>5/7/93</u>
140-164	hard red Sandrock	CASING: ☒ Length: <u>42</u> Feet Height above ground <u>1</u> Feet
165	Water 1 1/2 Gpm	☒ Steel Galv ☐ Plastic ☐ Cast Iron
166-193	hard red Sandrock w/ layers of red shale	Other _____ Type _____
194	Water 4 1/2 Gpm	SCREEN
195-285	hard red Sandrock w/ layer of red shale	☒ None Installed
		Type _____ Diameter _____
		Slot/Gauge _____ Length _____
		Set Between _____ Ft. and _____ Ft.
	<u>300 Gph</u>	

PUMPING OR BAILING TEST

DETAILS	#1	#2	#3
Static Water Level (Ft. Below Grade)	<u>90</u>		
Pumping Rate (GPM)	<u>5</u>		
Pumping Level (Ft. Below Grade)	<u>26.5</u>		
Duration of Test (In Hours)	<u>1</u>		
Recovery Time to Static Level (In Hours)	<u>1 1/2</u>		

WELL HEAD

Pitless Adapter: Type, Make, Etc. _____
Well Cap: Type, Make, Etc. Standard
Well Seal: Type, Make, Etc. _____
Well Platform: _____
Length _____ Width _____ Thickness _____
Grouting: ☒ Yes ☐ No
All Public Water Supplies must be grouted. pressure

I hereby certify that this well was drilled and constructed under my supervision, in compliance with all requirements of the referenced permit, and that this record is true to the best of my knowledge and belief.

B. Mark Smith 001
Name B.W. Smith Well Drilling Certification No. _____
Registered Business Name Benjamin Mark Smith
Signed _____ Date 5/7/93