

2

Feb/10
Date

INFORMATION TO BE
PRINTED OR TYPED

Hampshire HEALTH DEPARTMENT
ON-SITE SEWAGE DISPOSAL SYSTEM
INSPECTION FORM

T-550 P0003 F-558

Tax Map: 38 Parcel #: 42
County Road:

Name of Owner: LAURIE A. MUSE Installer: DAVID ADAMS 9 pmt 0.
Address: ~~GRASSY LICK RD P.O. Box 305~~ AUGUSTA GA 30604 4343 Stephens Rd.
Property Location: GRASSY LICK RD TO BETHEL CHURCH RD, TO LOST MOUNT RD RT, LOT 432 pmt, July 3, 2015
Type of Facility: RESIDENCE Facility is: New ☒ Existing () Lot Size: 3.457 Sq. Ft./Acres
Design Loading in gpd/No. Bedrooms: 3 Source of Water Supply: WELL

SEWAGE TANK COMPONENT

Capacity in Gallons: 1000 Material: Concrete Manufacturer: _____
Distances (in feet) of Tank to: Dwelling: 12 Private ☒ Public () Water Source: Yes Property Line: 100'

ON-SITE DISPOSAL SYSTEM

Class I Systems: Standard Soil Absorption Trenches () or Bed () Gravelless Pipe (), Diameter: _____ Inches
Chamber Soil Absorption Trenches (X) or Bed ()

Class II Systems: Pumped/Dosed Soil Absorption Trenches () or Bed () Evapotranspiration Trenches () or Bed ()
Shallow Soil Absorption Trenches () or Bed () Other: _____


No. of Lines: 3 Length (in feet) of Each: 60 , 60 , 60 , _____
Width of Trenches: 3 inches (feet) Depth to Bottom of Field: 24 inches
If Bed, Dimensions (in Feet): _____ If Chamber System, Name: _____, No. of Units: _____
Approved and Adequate Materials Used? Yes ☒ No () Size Equates to: 900 Square Feet of Standard Gravel Field
Distances (in feet) of System to: Dwelling: 475 Private () / Public () Water Source: 525' Property Line: 110
Remarks: _____

An inspection indicates that the sewage disposal system described above **DOES MEET (X)**, **DOES NOT MEET ()**, **CANNOT BE DETERMINED TO MEET ()** the minimum standards established by the West Virginia Bureau of Public Health.

To correct a health hazard, modifications to existing systems may be done to improve part of a system. Such modifications may not be able to be designated as a does meet system since inadequate information is known.

Although many factors contribute to the successful functioning of a sewage disposal system, this office recommends water conservation and maintaining an even usage of water throughout the week.

Sketch of Installation with Triangulation or Distance to Specific Landmarks:

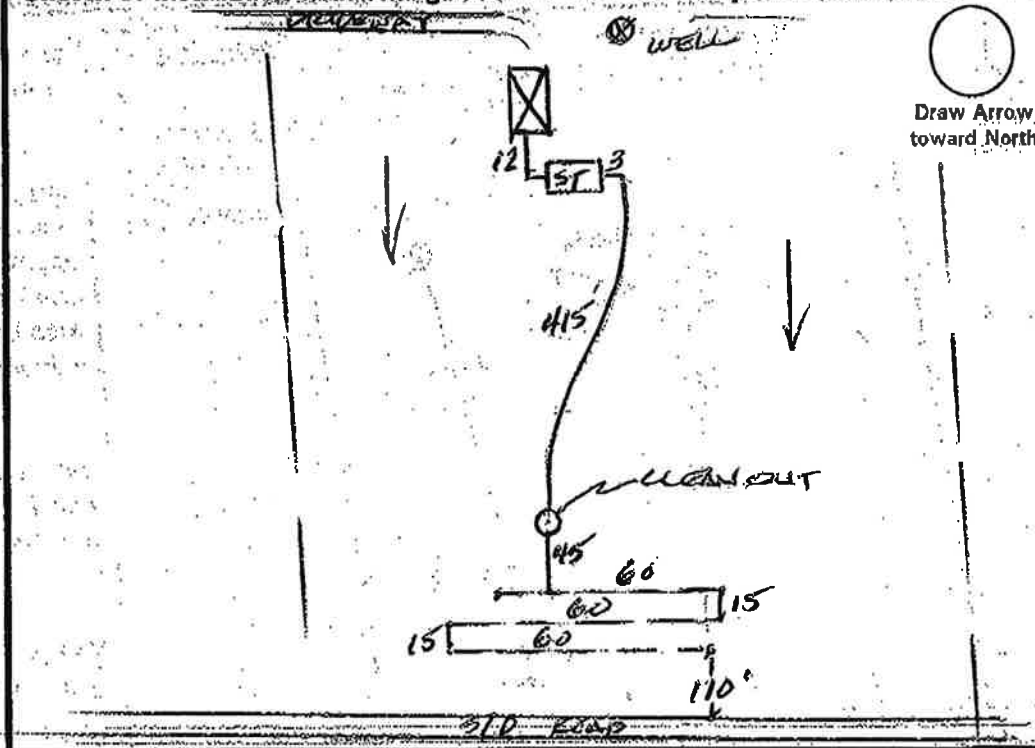

Visit Date(s): 9-14-04
Final Inspection Date: 2-9-06

Sanitarian: W. A. Letts