

PRINTED OR TYPED

Tax Map: 04A

Parcel #: 000

County: Hampshire

ON-SITE SEWAGE DISPOSAL SYSTEM
INSPECTION FORM

County Road: _____

Name of Owner: William & Susan Scott Installer: ED SNOOKMAKER
 Address: 7314 GELSE AVE BALTIMORE, MD 21219
 Property Location: NORTH RIVER WILDERNESS LOT #37
 Type of Facility: HOUSE Facility is: New (X) Existing () Lot Size: 5.8 Sq. Ft./Acres
 Design Loading in gpd/No. Bedrooms: 3 BR Source of Water Supply: well

SEWAGE TANK COMPONENT

+700 Pump Capacity in Gallons: 1000 Material: concrete Manufacturer: S&S
 Distances (in feet) of Tank to: Dwelling: _____ Private () / Public () Water Source: _____ Property Line: 10'

ON-SITE DISPOSAL SYSTEM

Class I Systems: Standard Soil Absorption Trenches () or Bed () Gravelless Pipe (), Diameter: _____ Inches
 Chamber Soil Absorption Trenches () or Bed ()
 Class II Systems: Pumped/Dosed Soil Absorption Trenches () or Bed () Evapotranspiration Trenches () or Bed ()
 Shallow Soil Absorption Trenches () or Bed () Other: LPR

No. of Lines: 5 Length (in feet) of Each: 60, 60, 60, 60, 60
 Width of Trenches: 12 inches/feet Depth to Bottom of Field: 12 inches
 If Bed, Dimensions (in Feet): _____ If Chamber System, Name: _____ No. of Units: _____
 Approved and Adequate Materials Used? Yes (X) No () Size Equates to: _____ Square Feet of Standard Gravel Field.
 Distances (in feet) of System to: Dwelling: _____ Private () / Public () Water Source: _____ Property Line: 10'
 Remarks: _____

An inspection indicates that the sewage disposal system described above

DOES MEET (X).


DOES NOT MEET ().

CANNOT BE DETERMINED TO MEET () the minimum standards established by the West Virginia Bureau of Public Health.

To correct a health hazard, modifications to existing systems may be done to improve part of a system. Such modifications may not be able to be designated as a does meet system since inadequate information is known.

Although many factors contribute to the successful functioning of a sewage disposal system, this office recommends water conservation and maintaining an even usage of water throughout the week.

Sketch of Installation with Triangulation or Distance to Specific Landmarks:

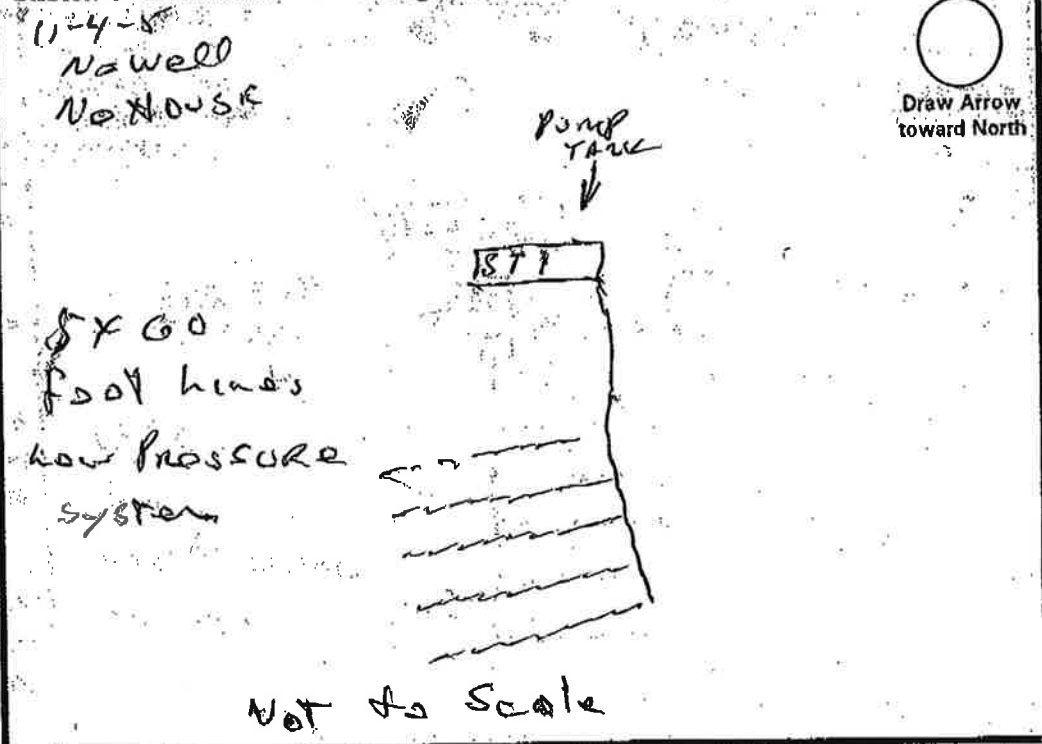

Visit Date(s): 7-29-05

Final Inspection Date: 11-4-05

Sanitarian: J. K. Kido