

GENERAL NOTES

1. THIS SURVEY WAS CONDUCTED IN ACCORDANCE WITH THE REQUIREMENTS OF THE ARIZONA DEPARTMENT OF LAND AND WATER.
2. THE SURVEY WAS CONDUCTED BY PUTT LAND SURVEYING, INC. ON BEHALF OF THE LANDOWNER.
3. THE SURVEY WAS CONDUCTED ON THE 15TH DAY OF MAY, 2001.
4. THE SURVEY WAS CONDUCTED BY PUTT LAND SURVEYING, INC. ON BEHALF OF THE LANDOWNER.
5. THE SURVEY WAS CONDUCTED BY PUTT LAND SURVEYING, INC. ON BEHALF OF THE LANDOWNER.
6. THE SURVEY WAS CONDUCTED BY PUTT LAND SURVEYING, INC. ON BEHALF OF THE LANDOWNER.
7. THE SURVEY WAS CONDUCTED BY PUTT LAND SURVEYING, INC. ON BEHALF OF THE LANDOWNER.
8. THE SURVEY WAS CONDUCTED BY PUTT LAND SURVEYING, INC. ON BEHALF OF THE LANDOWNER.
9. THE SURVEY WAS CONDUCTED BY PUTT LAND SURVEYING, INC. ON BEHALF OF THE LANDOWNER.
10. THE SURVEY WAS CONDUCTED BY PUTT LAND SURVEYING, INC. ON BEHALF OF THE LANDOWNER.

RECORDING DATA

BOOK OF RECORD NO. _____

PAGE NO. _____

DATE OF RECORD _____

NAME OF SURVEYOR _____

NAME OF LANDOWNER _____

NAME OF COUNTY _____

NAME OF TOWNSHIP _____

NAME OF RANGE _____

NAME OF SECTION _____

NAME OF QUARTER _____

LEGEND

--- BOUNDARY LINE

--- EASEMENT

--- RIGHT-OF-WAY

--- FENCE

--- ROAD

--- RAILROAD

--- WATER

--- POWER LINE

--- TELEPHONE LINE

--- GAS LINE

--- OIL PIPELINE

--- CULVERT

--- DRAINAGE

--- EROSION CONTROL

--- LANDMARK

--- MONUMENT

--- SURVEY POINT

--- BENCHMARK

--- ADJACENT PROPERTY



--- ADJACENT SECTION

--- ADJACENT QUARTER

--- ADJACENT TOWNSHIP

--- ADJACENT RANGE

--- ADJACENT COUNTY

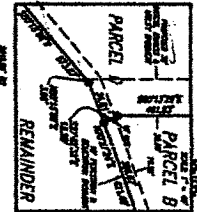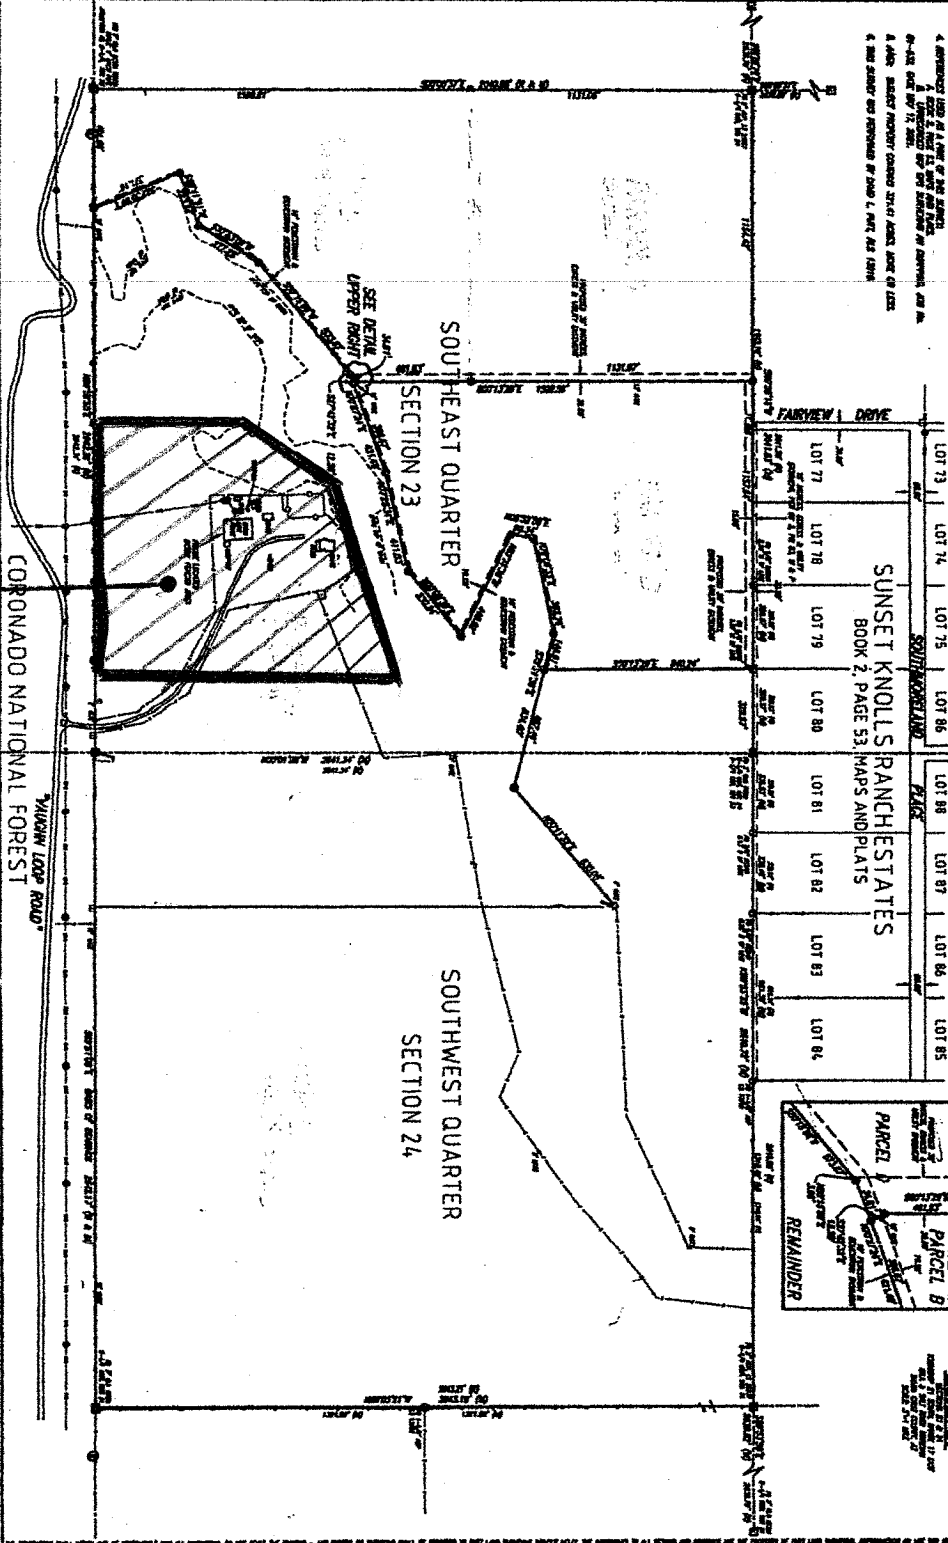

PLS PUTT LAND SURVEYING, INC.

430 N. CRYCROFT RD., SUITE 171, TUCSON, AZ 85711

TELEPHONE: (520) 790-8173 FAX: (520) 512-8173

RECORD OF SURVEY

THE SOUTHEAST QUARTER OF SECTION 23 & THE SOUTHWEST QUARTER OF SECTION 24

TOWNSHIP 21 SOUTH, RANGE 17 EAST

GILA & SALT RIVER MERIDIAN

SANTA CRUZ COUNTY, ARIZONA

NO.	DESCRIPTION	DATE
1	AS BUILT	05/15/01
2	AS BUILT	05/15/01
3	AS BUILT	05/15/01
4	AS BUILT	05/15/01
5	AS BUILT	05/15/01
6	AS BUILT	05/15/01
7	AS BUILT	05/15/01
8	AS BUILT	05/15/01
9	AS BUILT	05/15/01
10	AS BUILT	05/15/01

EXCLUDED 21+/- ACRES (PROPOSED)

1" = 77'