

3S-177  
Revised 1-71WEST VIRGINIA  
SEPTIC TANK INSPECTION FORM

Hampshire County Health Department

Installation Permit No. ST-14-81-29Name of Owner FOSTER, VERNON M.Address 7736 WILLIS AVE, FORT WASHINGTON, MARYLAND-20744Property Address 1/2 MILE SOUTH OF BLOOMERY RD. OLD RT 45, 1/2 MILE E N SANDY HOLLOW ROAD

## DESCRIPTION &amp; NUMBER OF UNITS SERVED

Type Facility Served HOUSE No. Water Closets 1  
TRAILER  
 Lot Size 2.2-ACRES sq. ft. Area suitable for sewage disposal installation 10,000 sq. ft.  
 Source of Water Supply DRIILLED No. Lavatories 1  
WELL  
 No. Bedrooms 2 No. Showers or Tubs 1 No. Baths 1  
 No. Garbage Grinders 0 No. Automatic Washers 1

## SEPTIC TANK

Material CONCRETE Length        x Width        x Depth        =        cubic feet  
 Liquid Depth        ft. Liquid Capacity 1,000 gal.  
 Distance to: Dwelling 40' Water Supply 95' Nearest Property Line 30'

## SOIL ABSORPTION SYSTEM

Type Drain Line Material PLASTIC Trench Width 36 ~~24~~ Inches  
 Trench Depth 30 Inches Total Absorption area in Trench Bottom 420 sq. ft.  
 Diameter of Drain Line 4 Inches Type Filter Media GRAVEL  
 No. of Drain Lines 2 Depth Filter Media Under Drain Line 6 Inches  
 Length of Each Line 70', 70' ft. Depth Filter Media Over Drain Line 2'  
 Distance of Disposal Field to: (a) Dwelling 50'  
 (b) Water Supply 110' (c) Nearest Property Line 20'

An inspection of the septic tank system described herein disclosed that said system (MEETS, ) the minimum standards established by the West Virginia State Department of Health.

Date


Oct. 9, 1981

Sanitarian

SKETCH OF SYSTEM TO BE DRAWN ON BACK

Note: Copy of this inspection report must be given to owner and the original filed in the Health Department files. PERMANENT RECORD - DO NOT DESTROY.

LL

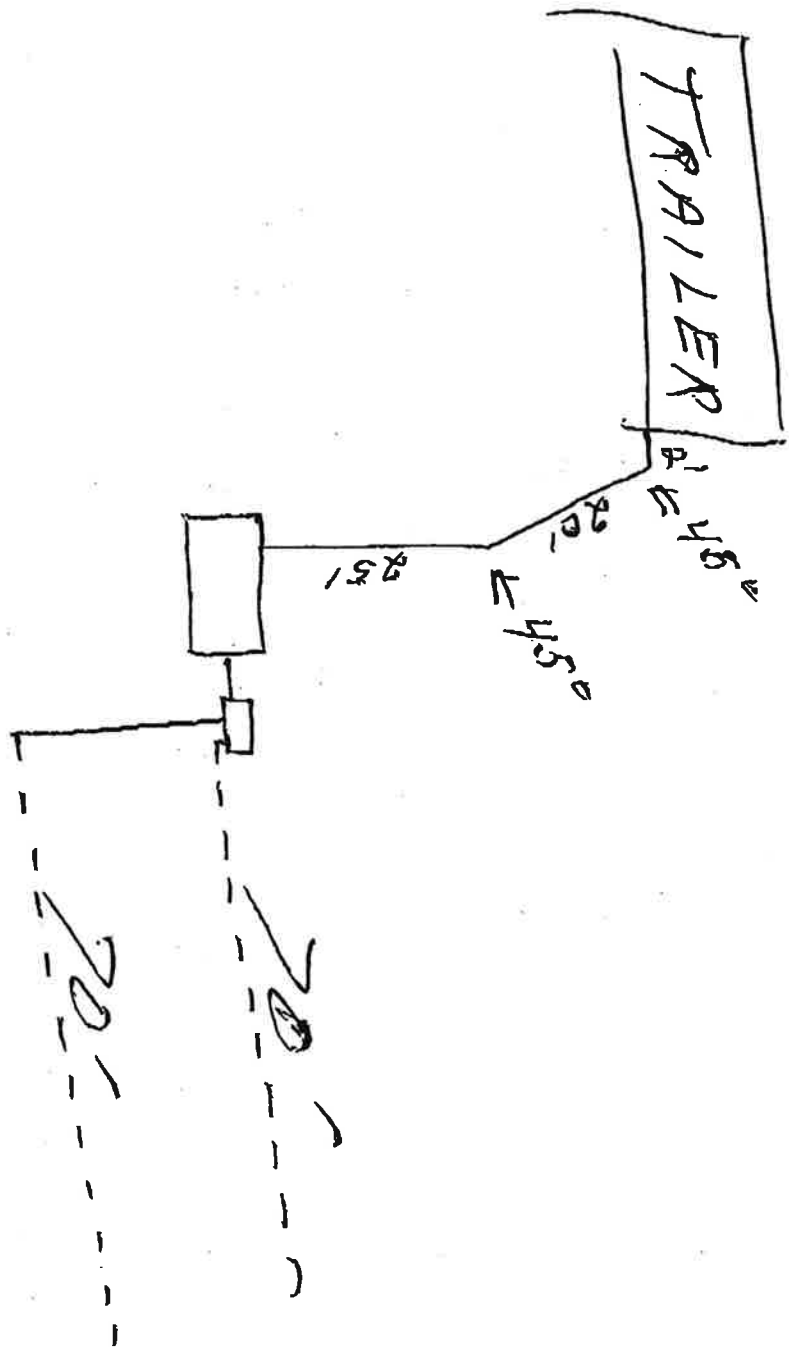

*[Handwritten signature]*