


DB.367
PG.787

FLINT HILL - SEC. 'A'
LOT 10

FLINT HILL ROAD
STATE ROUTE NO. 723
50' R/W

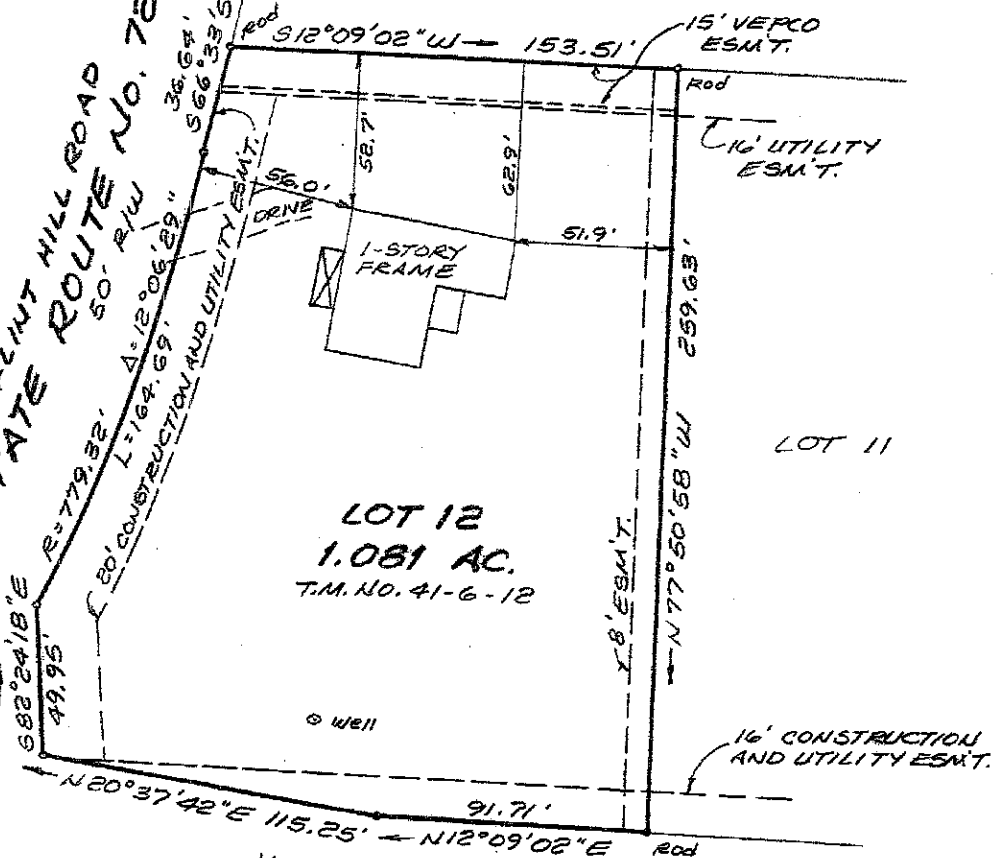

JUDES FERRY ROAD
STATE ROUTE NO. 613
50' R/W

PLAT SHOWING IMPROVEMENTS
ON LOT 12 OF A RESUBDIVISION OF
LOTS 12 AND 13, SECTION 'C' OF
- CHESTNUT ESTATES -

HUGUENOT DISTRICT - POWHATAN COUNTY, VA.

DATE: JULY 21, 2015 SCALE: 1" = 50'
REV: SEPTEMBER 13, 2015

NOTE:

- THIS PROPERTY IS NOT WITHIN A FEMA
DESIGNATED FLOOD HAZARD AREA,
SEE PANEL No. 51145C0150B.

Woodrow K. Cofer

09-13-2015

WOODROW K. COFER, INC.
CERTIFIED LAND SURVEYOR
POWHATAN, VIRGINIA
(804) 598-2014