


LEGEND

- Concrete Monument
- Electrical Transformer
- Gas Meter
- Fire Hydrant
- Monument
- Property Corner
- Light Pole
- Manhole
- Power Pole
- Cable Box
- Storm Inlet
- Telephone Pedestal
- Traverse Point
- Tree
- Valve Box
- Water Meter
- L.S.E. Landscape Easement
- B.L. Building Line
- U.E. Utility Easement

NOTES:

1. Plat Scale: 1" = 100'
2. The bearings for this survey are based on the recorded plat (record deed) shown on this survey.
3. Roads dedicated by recorded plat (record deed) unless otherwise noted.
4. This plat of survey has been performed with reliance upon title examination and abstracting performed by Old Republic Title Company under GF No.1302303 effective date of September 5, 2013. This surveyor has not abstracted the subject property.
5. The professional service reflected on this plat of survey is provided in connection with the transaction anticipated by the title search referenced and dated above, it is not to be used for any other purpose. This original work is protected under copyright laws, Title 17 United States Code Sections 101 and 102. All violators will be prosecuted to the fullest extent of the law. This survey is being provided solely for the use of the recipients named below and no license has been created, expressed or implied, to copy the survey except as is necessary in conjunction with the original transaction, which shall take place within thirty (30) days from the date shown hereon.
6. 5/8" Iron Rods with survey cap marked "Glezman 4627" set at all property corners unless otherwise noted.

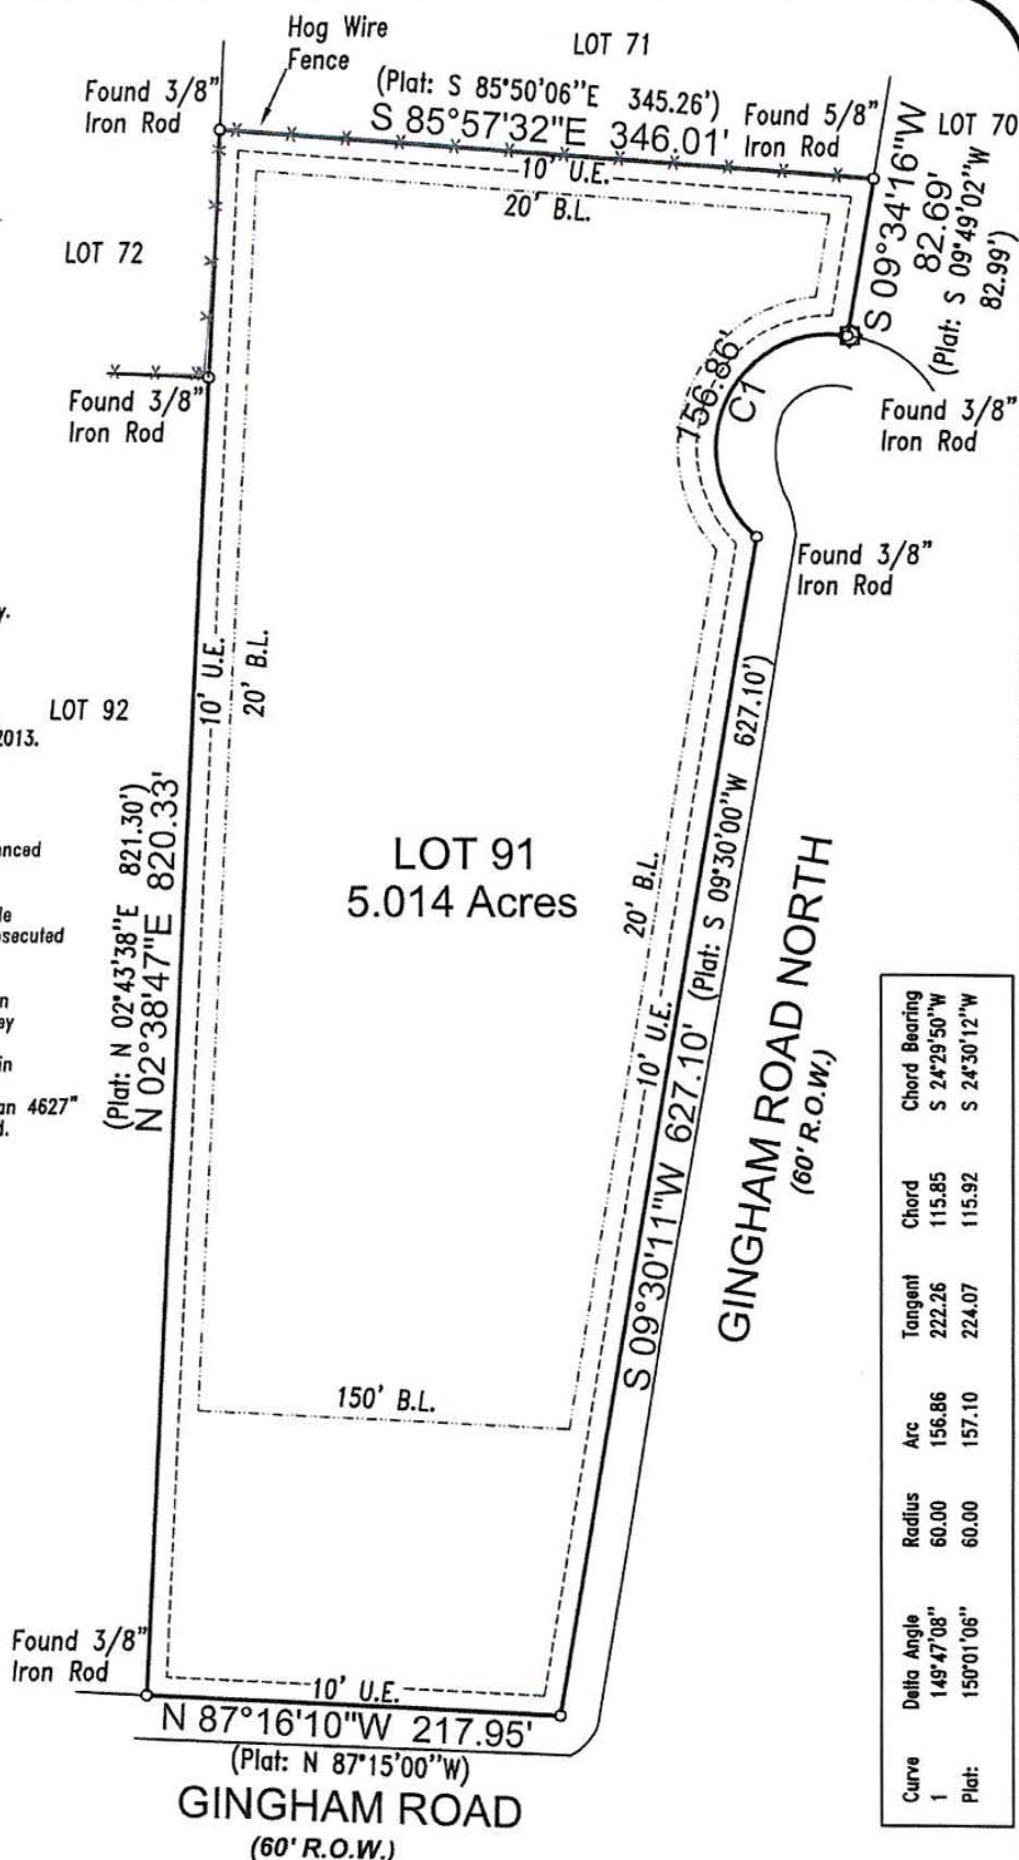

Lot 91, of WOOD CREEK, SECTION 1, a Subdivision in Montgomery County, Texas, according to the map or plat thereof recorded in Cabinet C, Sheet 34A of the Map Records of Montgomery County, Texas.

If this plat and accompanying description are not sealed with the raised embossing seal of R.P.L.S. whose signature appears on the raised seal and in red ink, it is considered a copy, and not a legal original. See Note 5 above.

Purchaser: John W. Soose and Betty M. Soose
Address: Gingham Road North
Montgomery, Texas

Date: 10/03/2013
Job No.: 2013-225

RPLS #4627

To: Capital Farm Credit, FLCA and Old Republic Title

We, Glezman Surveying, Inc., acting by and through Michael Glezman, a Registered Professional Land Surveyor in the State of Texas, hereby certify that this survey and professional services substantially complies with the Texas Society of Professional Surveyors Standards and Specifications for a Category 1A, Condition III Survey.

© 2013 All Rights Reserved

