

Revised 1-71

WEST VIRGINIA
SEPTIC TANK INSPECTION FORM

Wampsville, Christy Health Department Installation Permit No. ST-14-89-223

Name of Owner Charlton J. Wink

Address Rt. 2, Box 78, Leesburg, Va 22075

Property Address Old Gray Mtn Rd - 4 mls. from Rt. 50 - Behind log house

DESCRIPTION & NUMBER OF UNITS SERVED

Type Facility Served residence etc No. Water Closets 1

Lot Size 5+ acres sq. ft. Area suitable for sewage disposal installation 1 sq. ft.

Source of Water Supply well etc No. Lavatories 1

No. Bedrooms 3 No. Showers or Tubs 1 No. Baths 1

No. Garbage Grinders 1 No. Automatic Washers 1

SEPTIC TANK

Material pre-cast Length 100' x Width 36" x Depth 28" = 1,000 cubic feet

Liquid Depth concrete ft. Liquid Capacity 1,000 gal.

Distance to: Dwelling 100' Water Supply 100' Nearest Property Line 300'

SOIL ABSORPTION SYSTEM

Type Drain Line Material plastic Trench Width 36" Inches

Trench Depth 28" Inches Total Absorption area in Trench Bottom 720 sq. ft.

Diameter of Drain Line 4" Inches Type Filter Media 1 1/2" gravel 32-ton

No. of Drain Lines 3 Depth Filter Media Under Drain Line 6" Inches

Length of Each Line 80, 80, 80 ft. Depth Filter Media Over Drain Line 2 in

Distance of Disposal Field to: (a) Dwelling 100'

(b) Water Supply 100' (c) Nearest Property Line 250'

An inspection of the septic tank system described herein disclosed that said system (MEETS, DOES NOT MEET) the minimum standards established by the West Virginia State Department of Health.


10-2-89
Date

[Signature]
Sanitarian

SKETCH OF SYSTEM TO BE DRAWN ON BACK

Note: Copy of this inspection report must be given to owner and the original filed in the Health Department files. PERMANENT RECORD - DO NOT DESTROY.

Planned
House

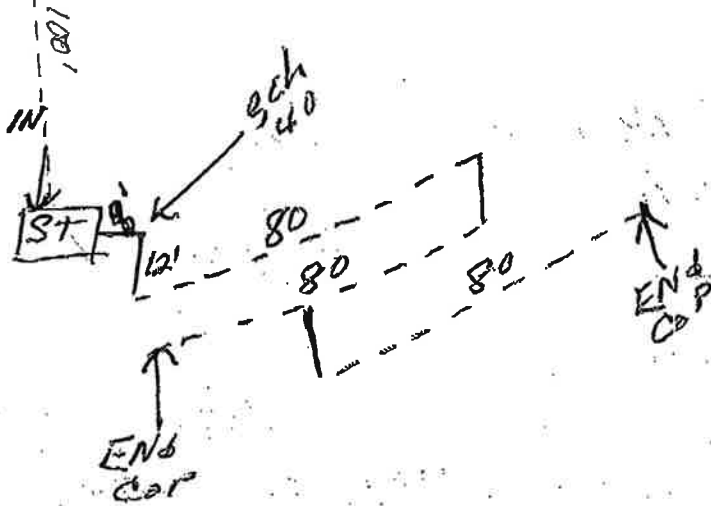

ALL
Transit
Reading
Within 2" OF Level

Loop
House

Rt 50 ← Old Jersey Mt. Road