

WV STATE DEPARTMENT OF HEALTH
Office of Environmental Health Services
ENVIRONMENTAL ENGINEERING DIVISION

SW258

WELL COMPLETION REPORT

Date(s) 10-23-01 County Hampshire Permit #: DW-14-02-74
 Town: Slanesville Area Name/Location Twin Springs Sub. Lot 13
 Well Owner: T. C. Alkire Address: P. O. Box 244
 Telephone Number: 496-1370 Slanesville, WV 25444
 Well Driller: Christopher Wolford Address: P. O. Box 412
 Telephone Number: 496-9972 Shanks, WV 26761

WELL LOG

DEPTH IN FEET	FORMATIONS: KIND, THICKNESS, AND IF WATER BEARING	REMARKS: <u>Pressure Grouted</u>
0-10	Brown Clay & Dirt	Type of Well: <u>D/W</u> Drilling Method: <u>Air Percussion</u>
10-21	Brown Sandstone	Well Diameter: <u>6 1/4"</u> Casing O.D.: <u>6 5/8"</u>
21-55	Red Shale	Well Depth: <u>220</u> Date Completed: <u>10-19-01</u>
55-59	Red Sandstone	CASING: Length <u>60</u> Feet Height above ground <u>1</u> Feet
59-94	Lt. Blue Sandstone	☒ Steel ☐ Plastic ☐ Cast Iron
94-130	Red Sandstone	Other _____ Type _____
130-174	Lt. Blue Sandstone	
174-220	Red sandstone	SCREEN
		☒ None Installed
		Type _____ Diameter _____
		Slot/Gauge _____ Length _____
		Set Between _____ Ft. and _____ Ft.

PUMPING OR BAILING TEST

DETAILS	#1	#2	#3
Static Water Level (Ft. Below Grade)	60		
Pumping Rate (GPM)	25		
Pumping Level (Ft Below Grade)	218		
Duration of Test (In Hours)	2		
Recovery Time to Static Level (In Hours)	1		

WELL HEAD

Pitless Adapter: Type, Make, Etc. _____
 Well Cap: Type, Make, Etc. Royer w/1" Conduit
 Well Seal: Type, Make, Etc. _____
 Well Platform: _____
 Length _____ Width _____ Thickness _____
 Grouting: ☒ Pressure ☐ Yes ☐ No
 All Public Water Supplies must be grouted.

hereby certify that this well was drilled and constructed under my supervision, in compliance with all requirements of the referenced permit, and that this record is true to the best of my knowledge and belief.

Christopher Wolford 10-23-01
 Name _____ Certification No. _____
Miller Bros. Drilling
 Registered Business Name _____
Chris Wolford 10-23-01
 Signed _____ Date _____

STATE OF WEST VIRGINIA

HEALTH DEPARTMENT

Permit No.: ST-14-02-124

Tax Map: Parcel #:

County Road:

INSPECTION TO BE
PRINTED OR TYPEDON-SITE SEWAGE DISPOSAL SYSTEM
INSPECTION FORM

County: Hampshire

Name of Owner: J.C. ALKIRE Installer: Ric Keiter
 Address: R.O. Box 244 JAMESVILLE WV 25144
 Property Location: Turn Springs Lot 13
 Type of Facility: House Facility is: New () Existing () Lot Size: 3.76 Sq. Ft./Acres
 Design Loading in gpd/No. Bedrooms: 3 BR Source of Water Supply: well

SEWAGE TANK COMPONENT

Capacity in Gallons: 1000 Material: concrete Manufacturer: J.C. D
 Distances (in feet) of Tank to: Dwelling: 23 Private () Public () Water Source: 50' Property Line: 10' 4"

ON-SITE DISPOSAL SYSTEM

Class I Systems: Standard Soil Absorption Trenches () or Bed () Gravelless Pipe () Diameter: 10 Inches
 Chamber Soil Absorption Trenches () or Bed ()
 Class II Systems: Pumped/Dosed Soil Absorption Trenches () or Bed () Evapotranspiration Trenches () or Bed ()
 Shallow Soil Absorption Trenches () or Bed () Other:


No. of Lines: 2 Length (in feet) of Each: 100, 100, 100, _____
 Width of Trenches: 24 inches/feet Depth to Bottom of Field: 2436 inches
 If Bed, Dimensions (in Feet): _____ If Chamber System, Name: _____ No. of Units: _____
 Approved and Adequate Materials Used? Yes () No () Size Equates to: 900 Square Feet of Standard Gravel Field.
 Distances (in feet) of System to: Dwelling: 43 Private () Public () Water Source: 100' Property Line: 10' 4"
 Remarks: To BE

An inspection indicates that the sewage disposal system described above
DOES MEET ()
DOES NOT MEET ()
CANNOT BE DETERMINED TO MEET () the minimum standards established by the West Virginia Bureau of Public Health.

To correct a health hazard, modifications to existing systems may be done to improve part of a system. Such modifications may not be able to be designated as a does meet system since inadequate information is known.

Although many factors contribute to the successful functioning of a sewage disposal system, this office recommends water conservation and maintaining an even usage of water throughout the week.

Sketch of Installation with Triangulation or Distance to Specific Landmarks:
 10-11-01

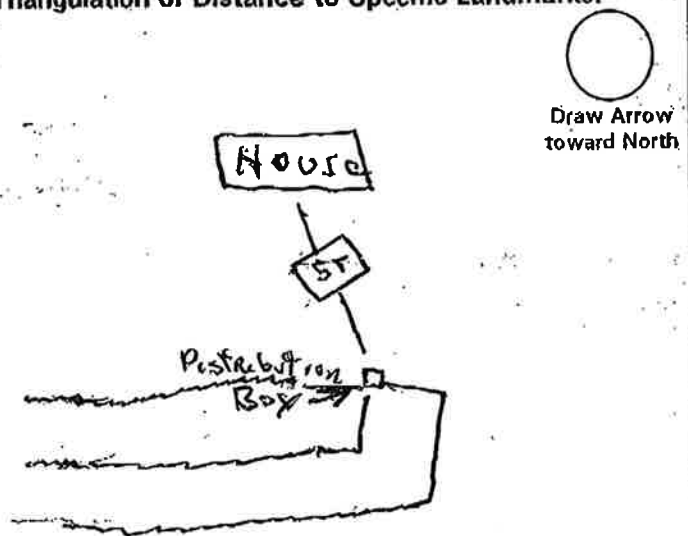

Not to Scale

Visit Date(s): 10-3-01
 Final Inspection Date: 10-11-01

Sanitarian: J. K. Keiter