

Tax Code: 08-045-009
System Type: II-C
Zoning: RA-40

Union County
On-Site Wastewater Disposal System
Construction Authorization

Number: 99-796
Date Issued: 11-23-99
Expiration Date: 11/23/99

This Construction Authorization is issued by the Union County Health Department to construct and install the work hereby described. The construction shall be made in compliance with the N.C. Department of Environment, Health, and Natural Resources Laws and Rules for Sewage Treatment and Disposal Systems, 15A NCAC 10A 1900. Any unauthorized changes to the site or system design shall void this Construction Authorization.

Owner: Lloyd Simpson
Mailing Address: 7612 Haigher Gin Rd Moore NC 28110
Phone: (h) (704) 753-1722 (w) () Fax: ()
Location: Bacon Manor Subdivision Phase Section: Lot #
Directions: 200 N (R) on Bacon Manor Rd, 1/2 mile on (L)

Installation for: House: Mobile Home: X Duplex:
Number of Bedrooms: 3 Garbage Disposal (y/n): N
Water Supply to be: Individual Well: X Public Water: Other:
Commercial: Industrial:
Other: (Describe: Number of Employees:
Church: Seating Capacity of Sanctuary:
Kitchen Facilities in Church: (y/n) Day Care (y/n):

New Installation
Design Waste Flow: 300 (G.P.D.)

Type of System:

Conventional: Modified Conventional: X Pump to Conventional:
LPP: Mound: At-Grade Mound: Other (Describe):
Experimental/Innovative: Pre-Treatment: Sand: Bio-Filter:
Design by: Soil Scientist: Engineer:

Septic Tank: Capacity: 1000 gal. Compartments: 2 If Site Built: L: W:
Liquid Capacity:

Pump Tank: Capacity: gal. Pump Flow: gal./minute @ feet of Total Dynamic Head

Drainfield: Total Length of Lines: 400' Total square feet of disposal area: 1200 Line Length: 100'
Line Width: 30 inches Washed Stone Depth: 12" Maximum depth of lines: 18"
Maximum Grade: Level Distribution Device: D-Box

System Distance to nearest: Well: 100' Water Line: 16' Foundation: 5' Property Line: 10'

Addition / Repair:

Previous On-Site Wastewater Permit Number:

Repair Components:

Septic Tank: Capacity: gal.

Pump Tank: Capacity: gal.

Pump flow: gal./min. @ TDH

Drainfield: Total length: Individual line length:

Line width: Depth of washed stone:

Other:

Comments & Special Conditions:

FLOOD
*** SEE AS-BUILT**

I hereby certify that the construction described in this Construction Authorization will be done in accordance with this permit and with the Ordinances, State Laws, Rules and Regulations of the State of North Carolina and the Union County Health Department. **NOTICE:** The issuance of this permit does not relieve the property owner of his responsibility for checking his proposed development with applicable zoning requirements.

Signed: Lloyd Simpson

Permit Prepared by: E. Logan Butler

Date: 11/23/99 Contractor:

Final Inspection by: Ramona E. Gentry


Date: 5/16/00 Certified Operator:

Tax Code: 08-045-009
Const. Auth./ Permit Number: 99-796

Union County Health Department
On-Site Wastewater Disposal System "As Built" Addendum

Date: 4-19-00

Owner: Lloyd Simpson Address: 7612 Haigler Fin Rd. Monroe NC 28110 Phone: (h) 753-1722 (w) _____
Property Location: Road/Street: Baughman Subdivision: _____ Phase: _____ Section: _____ Lot #: _____
On-Site Wastewater System Contractor: Carl Hildreth Change to System: Pump-to-conventional
Reason for Change: moved tanks & relocated m.h.
Environmental Health Specialist: Ramona E. Askins

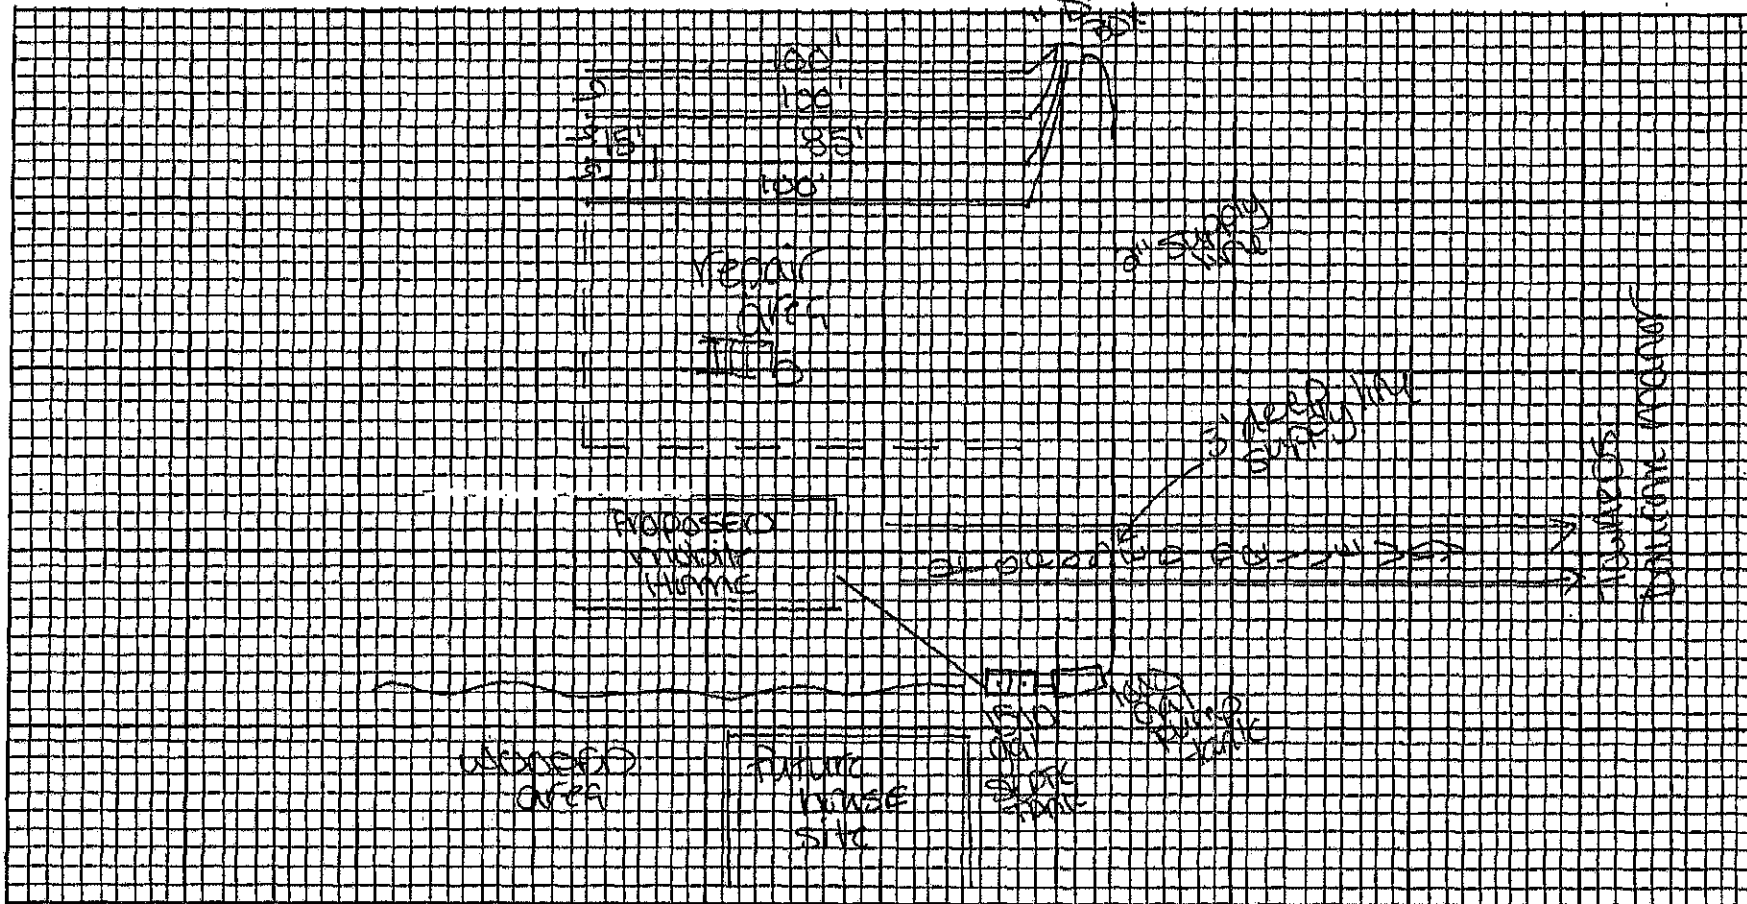

Scale: 1"=40' Direction of North: _____