

# DAVIE COUNTY HEALTH DEPARTMENT

## IMPROVEMENTS PERMIT AND CERTIFICATE OF COMPLETION

NOTE: Issued in Compliance with G.S. of North Carolina Chapter 130 Article 13c  
Sewage Treatment and Disposal Rules (10 NCAC 10A .1934-.1968)

Permit Number

No 5496

Name Jay H. Mintz Date 4-5-89

Location 3730 Kirklees Road Winston-Salem NC 27107

1 E 11th 1015 - 11th P 200 G 216

Subdivision Name \_\_\_\_\_ Lot No. \_\_\_\_\_ Sec. or Block No. \_\_\_\_\_

Lot Size 125 acw House ☒ Mobile Home \_\_\_\_\_ Business \_\_\_\_\_ Speculation \_\_\_\_\_

No. Bedrooms 4 No. Baths 6 No. in Family 5

Garbage Disposal YES ☒ NO ☐

Auto Dish Washer YES ☒ NO ☐


Auto Wash Machine YES ☒ NO ☐

Type Water Supply Co.

Specifications for System:

1500 gal tank - D-B-V  
60'0" X 3' X 12"

\*This permit Void if sewage system described below is not installed within 36 months from date of issue.

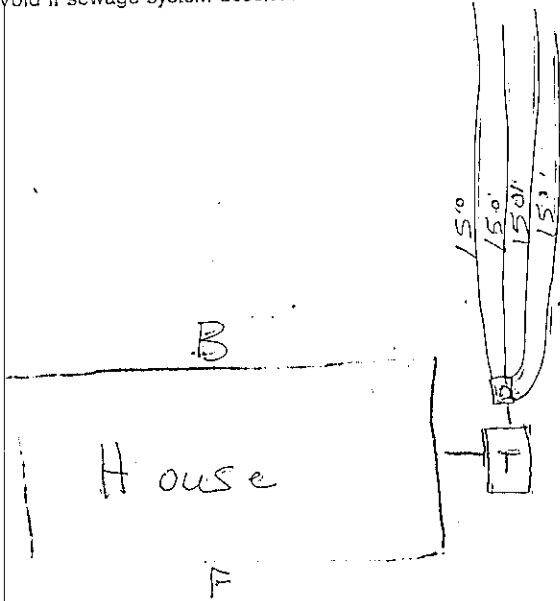

Improvements permit by Charles E. Battle


\*Contact a representative of the Davie County Health Department for final inspection of this system between 8:30-9:30 A.M. or 1:00-1:30 P.M. on day of completion. Telephone Number: 704-634-5985.

Final Installation Diagram:

System Installed by Minnie S. Smith

Each line 200

8-16

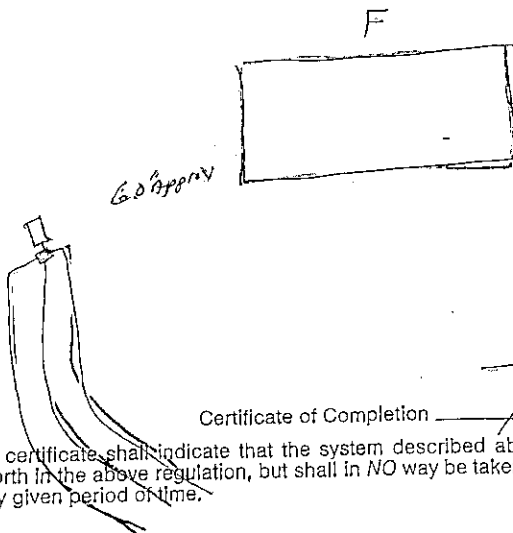

Certificate of Completion

Date

11/14/89

\*The signing of this certificate shall indicate that the system described above has been installed in compliance with the standards set forth in the above regulation, but shall in NO way be taken as a guarantee that the system will function satisfactorily for any given period of time.

1568 Peoples Ck Rd.