

Date(s) 6/2/86 County Honolulu Permit #: DW-14-05-86-206
 Town: Riely Area Name/Location Riely
 Well Owner: Megay Ricken Address: Rt 3 Box 70
 Telephone Number: 304-822-5310 Romney W, Va. 26757
 Well Driller: Roger T.D. Hansen Address: HC 36 Box 91
 Telephone Number: 703-888-3800 Winchester Va 22601

WELL LOG

DEPTH IN FEET	FORMATIONS: KIND, THICKNESS, AND IF WATER BEARING	REMARKS:
0-18	Yellow Slate	Type of Well: <u>Water</u> Drilling Method: <u>Air Hammer</u>
18-160	Gray Slate	Well Diameter: <u>6</u> Casing O.D.: <u>6 5/8</u>
160-161	Water bearing 5gal	Well Depth: <u>200</u> Date Completed: <u>6/2/86</u>
161-180	Gray Slate	CASING: Length <u>21</u> Feet Height above ground <u>1.5</u> Feet
180-181	Water bearing 5gal	☒ Steel ☐ Plastic ☐ Cast Iron
181-200	Gray Slate	Other _____ Type _____
		SCREEN
		☒ None Installed
		Type _____ Diameter _____
		Slot/Gauge _____ Length _____
		Set Between _____ Ft. and _____ Ft.

PUMPING OR BAILING TEST

DETAILS	#1	#2	#3
Static Water Level (Ft. Below Grade)	35		
Pumping Rate (GPM)	10		
Pumping Level (Ft Below Grade)			
Duration of Test (In Hours)			
Recovery Time to Static Level (In Hours)			

WELL HEAD

Pitless Adapter: Type, Make, Etc. _____
 Well Cap: Type, Make, Etc. Vertical Rayer
 Well Seal: Type, Make, Etc. _____
 Well Platform: To be installed by Owner
 Length _____ Width _____ Thickness _____
 Grouting: ☐ Yes ☒ No
 All Public Water Supplies must be grouted.

I hereby certify that this well was drilled and constructed under my supervision, in compliance with all requirements of the referenced permit, and that this record is true to the best of my knowledge and belief.

Roger T.D. Hansen 021
 Name Certification No.
Roger T.D. Hansen
 Registered Business Name
Roger T.D. Hansen 6/2/86
 Signed Date

Name of Owner: GREG & LISA RINKER Installer: ORNDORFF
Address: HQ 78 BOX 51A
Property Location: 50N TO S. FORK OF LITTLE CANAW TO RALEY RD (1ST HOUSE ON HILL)
Type of Facility: RESIDENCE Facility is: New () Existing (X) Lot Size: 11.27 Sq. Ft./Acres
Design Loading in gpd/No. Bedrooms: 3 Source of Water Supply: WELL

SEWAGE TANK COMPONENT

Capacity in Gallons: EXISTING 1000 Material: concrete Manufacturer: _____
Distances (in feet) of Tank to: Dwelling: 75 Private (X)/Public () Water Source: 100+ Property Line: 250+

ON-SITE DISPOSAL SYSTEM

Class I Systems: Standard Soil Absorption Trenches () or Bed () Gravelless Pipe (X), Diameter: 10 Inches
Chamber Soil Absorption Trenches (X) or Bed ()
Class II Systems: Pumped/Dosed Soil Absorption Trenches () or Bed () Evapotranspiration Trenches () or Bed ()
Shallow Soil Absorption Trenches () or Bed () Other: _____

No. of Lines: 2 ADDITIONAL Length (in feet) of Each: 80, 80, _____, _____, _____
Width of Trenches: 3 inches (feet) Depth to Bottom of Field: 24 inches
If Bed, Dimensions (in Feet): _____ If Chamber System, Name: _____, No. of Units: _____
Approved and Adequate Materials Used? Yes (X) No () Size Equates to: _____ Square Feet of Standard Gravel Field.
Distances (in feet) of System to: Dwelling: 75 Private (X)/Public () Water Source: 100 Property Line: 250+
Remarks: _____


An inspection indicates that the sewage disposal system described above **DOES MEET** (X), **DOES NOT MEET** (), **CANNOT BE DETERMINED TO MEET** () the minimum standards established by the West Virginia Bureau of Public Health.

To correct a health hazard, modifications to existing systems may be done to improve part of a system. Such modifications may not be able to be designated as a **does meet** system since inadequate information is known.

Although many factors contribute to the successful functioning of a sewage disposal system, this office recommends water conservation and maintaining an even usage of water throughout the week.

Sketch of Installation with Triangulation or Distance to Specific Landmarks:

Draw Arrow toward North

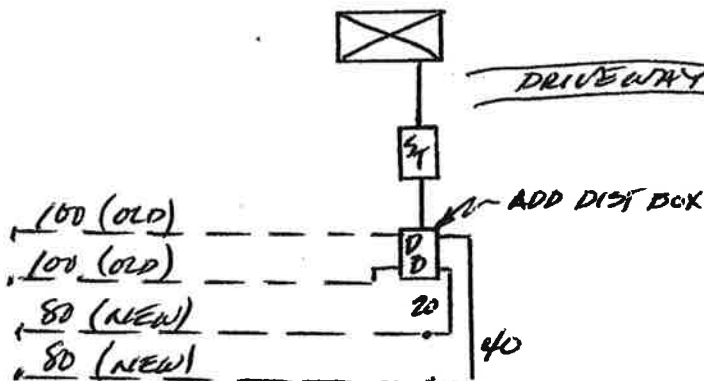

Visit Date(s): 5-30-06
Final Inspection Date: 5-31-06

Sanitarian: D. White