

# SEPTIC TANK INSPECTION RECORD

Environmental Health Division

Gaston County Health Department

Code

Date

Owner

Permit By

OCCUPANT

OWNER

LOCATION

off Crowders Creek Rd - Turn onto private Rd, just past Fox Fire Subdivision -

DESIGNED FOR:

2 Bedrooms, Washing Machine, Garbage Disposal; not more than 4 persons.

SEPTIC TANK: capacity

1000 gallons; Block, Precast A. M. S. Mfg.

NITRIFICATION FIELD:

800 sq. feet of trench: 2 lines in 2 trench (s) bed (s)

100 feet long

3 feet wide, 4 inch concrete plastic terra cotta drain tile: 12

inches of crushed stone, with 8 inches under tile.

Seepage pit (s)

feet long. feet wide. feet stone. No. lines

SAND FILTER:

feet long feet wide with lines on top and lines on bottom. inch tile.

WATER SUPPLY:

Municipal Community Non Community Private

CONTRACTOR:


Romyne Rogers

INSPECTED BY:

A. M. S.

lake bed

LOCATION

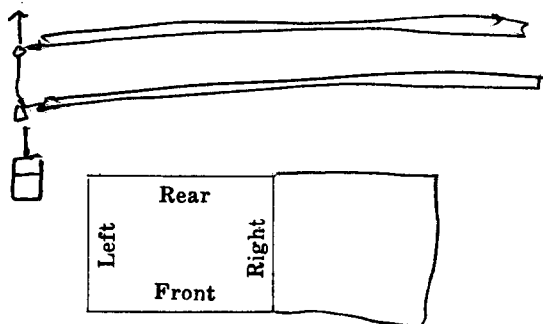

HOUSE SEWER: not in place feet from right left front rear corner.

SEPTIC TANK: Front, rear right side left side of building.  
Perpendicular parallel, angle 5 feet from building.

DISTRIBUTION BOX: 10 feet from end side, corner of septic tank.

NITRIFICATION FIELD OR FILTER: 5 feet from building at nearest point.

WELL (IF ANY): 100+ feet from septic tank  
and 100+ feet from disposal field.

SOIL APPEARANCE: Suitable, Provisionally suitable

REMARKS: Trailer Temporary - House to  
built later