



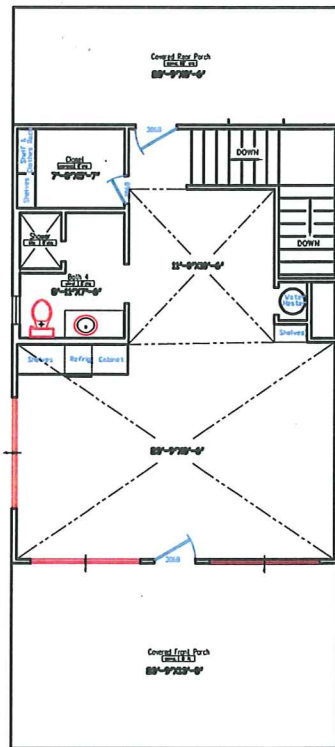

UPSTAIRS FLOOR PLAN
1/4"=1'-0"

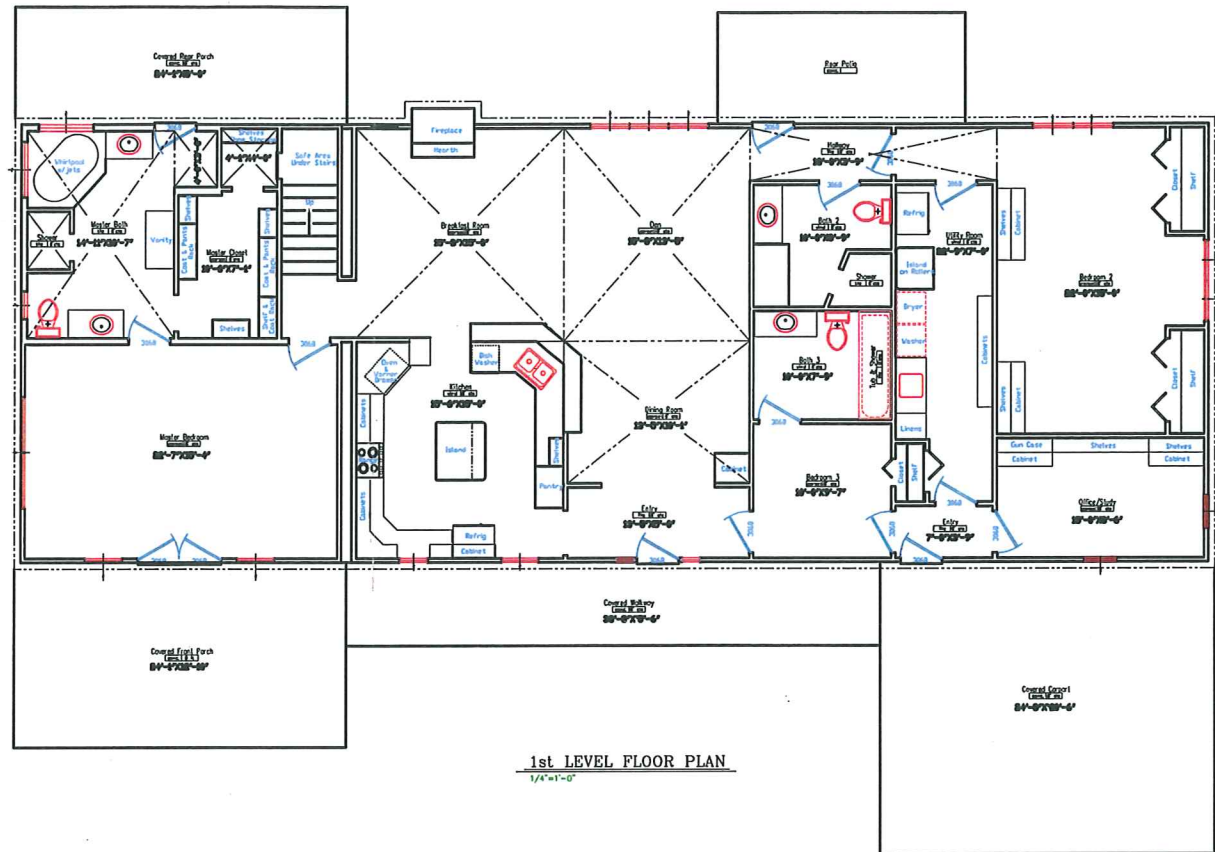

1st LEVEL FLOOR PLAN
1/4"=1'-0"

NO.	DATE	DESCRIPTION	CEH	CEH
0	12/09/09	ISSUED "AS-BUILT" FOR RECORD PRINT	CEH	CEH
REVISIONS				
This drawing is the property of Henley Engineering, Inc. and is not to be reproduced, stored, or transmitted in any form or by any means, electronic, mechanical, or otherwise, without the prior written permission of Henley Engineering, Inc. The user of this drawing is to be held responsible for any errors or omissions in the drawing and for any consequences thereof.				SCALE: 1/4"=1'-0"
PLAN CHARLES & SISSIE HENLEY RESIDENCE 2456 RANCH ROAD 962 WEST BLANCO COUNTY				
SHEET 1 OF 1				
DRAWING NO.	A-291209	DRAWN BY:	C.E. HENLEY	DATE
		PROJECT	HOME SALE	REV.
				0

