

File Number: 98/85
System Type: Pa

Davidson County Health Department
Operations Permit

Johnnie Van Reekel
Applicant's Name

Superna East 21
Subdivision/Section/Lot #

M. E. Mahon
Wastewater System Installer

C. J. K.
Authorized State Agent

2-17-00
Date

Permit Conditions:

Septic Tank 1000


Nitrification Field (Sq. Ft.) = 1200

Pump Tank 1000

Nitrification Line (Linear Ft.) = 300

Filter Type Zabel

Lines Installed 11-8-99
gle

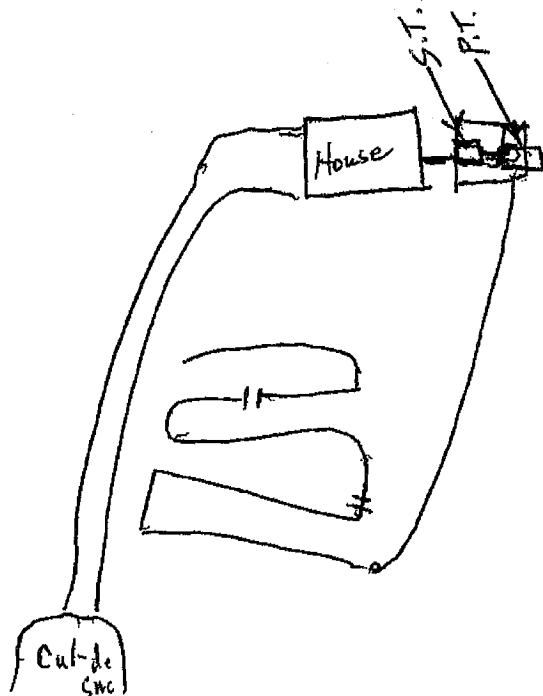

Davidson County Health Department

Improvement Permit

If the information on the Improvement Permit is falsified, changed or the site is altered, then the Improvement Permit shall become invalid.

Permit is Valid for Five Years:

No Expiration date:

1-25-99 Date Rec. Map Code: G4-A4 File No.: 1998 / 85A
VAN ROEKEL JOHNNIE 623 CARDINAL DR
Applicant Address LEXINGTON NC 27292 Daytime Phone 336 242-1527
VAN ROEKEL JOHNNIE
Owner/Legal Representative Address Daytime Phone
SAPONA EAST 21 11 LEXINGTON
Subdivision S TO TUSSEY Map Lot Sec Township
OLD HWY 29 TUSSEY RD PROPERTY ON EAST SIDE APPROX 1 MI
Road Name Specific Directions to Property
Facility Type: H New ☒ Repair Expansion Water Supply PUBL
No. of Bedrooms: 3 No. of Occupants: Basement YES Basement Fixtures
No. of Employees: Other: Projected Daily Flow 360
Pump: Yes ☒ No ☐ Proposed Wastewater System Type: PPBPS
Permit Conditions: Site has been changed this is the new system
type for lots (Site changed from what was issued)
Waterline under driveway
Permit Granted: ☒ Permit Denied: ☐ Authorized State Agent Todd Taylor Date 1-26-99
Owner/Legal Representative's Signature: [Signature] Date 1/27/99

Authorization To Construct Wastewater System

The Authorization for Wastewater System Construction is subject to revocation if the site plan or plat changes, the intended use of the property changes, or if the site is altered or is misrepresented in any way.

Type of Wastewater System: PPBPS Projected Daily Flow: 360

Wastewater System Requirements

Tank Size: 1000 Pump Tank Size: 1000 Square Footage: ~1200
Trench Length: 200A Max. Trench Depth: 30" Trench Width: 2A
No. of Trenches: 5 lines 40A each Aggregate Depth: Sand (Rocks/Lime)
Permit Conditions: See above conditions (Due to change in site)
15A from foundation

See Site Plan / Plat On Attached Sheet

Permit Granted: ☒ Permit Denied: ☐ Authorized State Agent Todd Taylor Date 1-26-99

Owner/Legal Representative's Signature: [Signature] Date 1/27/99

98/857A

Rockel, Johnnie

3 B1 w/ Base
to PPBPS

B1 w/ ~~ball~~
Pump to PPBPS

