

Operation Permit

Brandon Layton

Banks Rd 37606

Applicants Name

Subdivision/Section/Lot#

← BANKS RD. →

THIS SYSTEM HAS BEEN INSTALLED IN COMPLIANCE WITH APPLICABLE NORTH CAROLINA GENERAL STATUTES, RULES FOR SEWAGE TREATMENT AND DISPOSAL, AND ALL CONDITIONS OF THE IMPROVEMENT PERMIT AND CONSTRUCTION AUTHORIZATION.

April B. Underwood R.S.

03/24/2008


Authorized State Agent

Date

← DRIVEWAY →

Cabarrus County
Stanly County

UTILITY RIGHT OF WAY

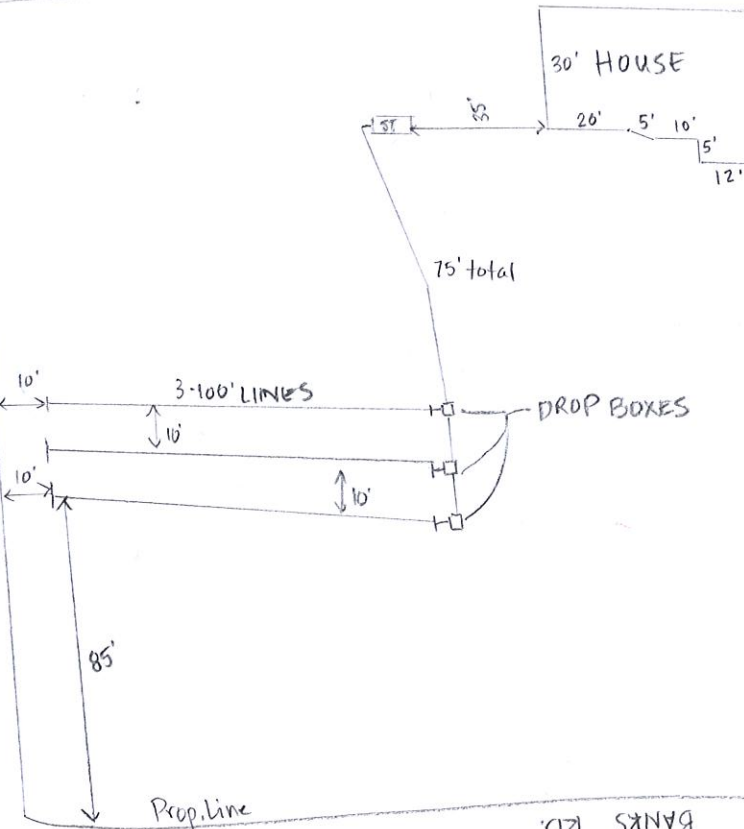

STANLY COUNTY ENVIRONMENTAL HEALTH DEPARTMENT
IMPROVEMENT PERMIT

Taxrec 32812 EH# 3876

A building permit cannot be issued with only an Improvement Permit

Z.C.#

Type of Structure: Home

Permit Expires: 01/17/2011

GPD: 360

Characteristics: Domestic

Phone:

Applicant: Kent Newport

of Occupants: 2

of Bedrooms: 3

Deed Reference: 689:297

Facility Type: New

Water Supply: New Well

Subdivision: Banks Rd

Section/Phase/Lot:

Basement:

Basement Fixtures:

Permit Conditions:

Conventional initial and repair.

Owner:

Date:

Authorized State Agent:

Ryan Ryge, R.S.

Date:

01/17/2006

The issuance of this permit by the Health Department in no way guarantees the issuance of other permits. The permit holder is responsible for checking with appropriate governing bodies in meeting their requirements. This permit is subject to revocation if the site plan, plat, or the intended use changes. The Improvement Permit shall not be affected by a change in ownership of the site. This permit is subject to compliance with the provisions of the Laws and Rules for Sanitary Sewage Collection, Treatment, and Disposal, of the North Carolina Administrative Code.

