

KENDALL COUNTY
Department of
DEVELOPMENT MANAGEMENT
201 East San Antonio Street, Suite 100
Boerne, Texas 78006
Telephone: (830) 249-9343 Ext. 201

FILE # S 8458

SEPTIC FORM

Private Sewage Facility (Licensed) in Kendall County, Texas

APPLICANT INFORMATION:

Property Owner Lorelei Goldbeck Installer/Lic.# Ray Fischer 02271
(Licensee)

Subdivision or Location 4592 Ranger Creek Rd

No. Bedrooms 5 + 2 or Sq. Ft. of House 4703 + 420 of Gal/Day 600


Application rate for surface irrigation .064 loading rate based on soil type

Class No. IV Trench Req. Sq. Ft. 9375 Aerobic Type

Gallon Capacity Req. for Concrete Septic Tank 1000 G.P.D. - 1000 Pump Tank Bio Rokit

Installed: Length Width
Sq. Ft. 9616 Bed Trench

Remarks:
(Sketch of Approximate Distances, Not To Scale.)

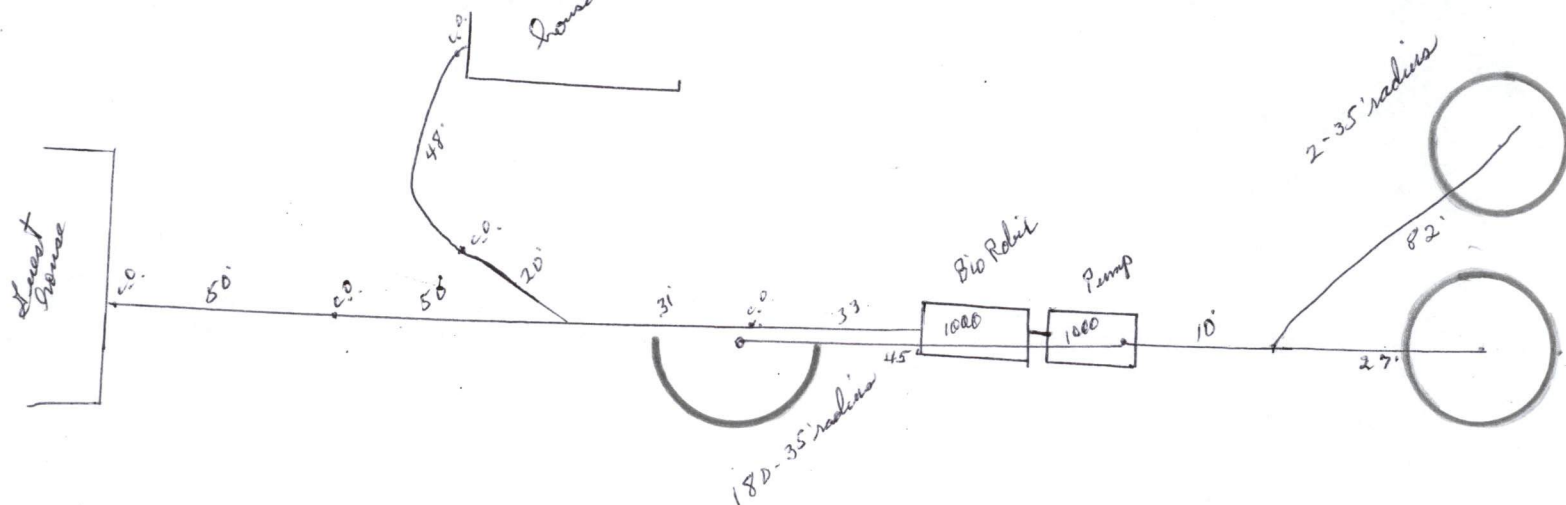

The County of Kendall, The Texas Department of Health, or their agents or designees, makes no representation that facilities herein licensed will provide satisfactory service to the premises served. It will be the licensee's responsibility to make any changes or modifications which operating experience may show to be necessary in order for these facilities to provide satisfactory service. Septic distances meet minimum Texas Department of Health separation distances in most instances. Some renovations may be less if repaired or replaced in the same general area as the pre-existing system being renovated.

PERMIT (LICENSE) GRANTED AND APPROVED THIS DATE 11-2-2010

Sanford Jennings
Designated Representative