

09-05-'13 10:12 FROM- hamp health dept
Revised 1-71

3044989850

T-399 P0003

F-405

WEST VIRGINIA

SEPTIC TANK INSPECTION FORM

① Hampshire Health Department Installation Permit No. 54-14-93-004
Name of Owner James A. Duling
Address Box 377- Romney W.V.
Property Address Upper Cacapon Rd 500 yds. Past Hedi Cooper Bridge
DESCRIPTION & NUMBER OF UNITS SERVED up Hill on left through gate.
Type Facility Served Mobile Home No. Water Closets _____
Lot Size 1 sq. ft. Area suitable for sewage disposal installation _____ sq. ft.
Source of Water Supply Well No. Lavatories _____
No. Bedrooms 3 No. Showers or Tubs _____ No. Baths _____
No. Garbage Grinders _____ No. Automatic Washers 1

SEPTIC TANK

Material Concrete 40 in Length _____ x Width _____ x Depth _____ = _____ cubic feet
Liquid Depth _____ ft. Liquid Capacity 1000 gal.
① Distance to: Dwelling 20' Water Supply 95' Nearest Property Line 100'

SOIL ABSORPTION SYSTEM

Type Drain Line Material 2729 Plastic Trench Width 36 Inches
Trench Depth 24 Inches Total Absorption area in Trench Bottom 750 sq. ft.
Diameter of Drain Line 4 Inches Type Filter Media 1 1/2 gravel
No. of Drain Lines 3 Depth Filter Media Under Drain Line 12 Inches
Length of Each Line 80, 100, 70 ft. Depth Filter Media Over Drain Line 2 ft.
Distance of Disposal Field to: (a) Dwelling 38'
(b) Water Supply 100' (c) Nearest Property Line 20'

An inspection of the septic tank system described herein disclosed that said system (MEETS, DOES NOT MEET) the minimum standards established by the West Virginia State Department of Health.

11-28-92
Date

[Signature]
Sanitarian

SKETCH OF SYSTEM TO BE DRAWN ON BACK

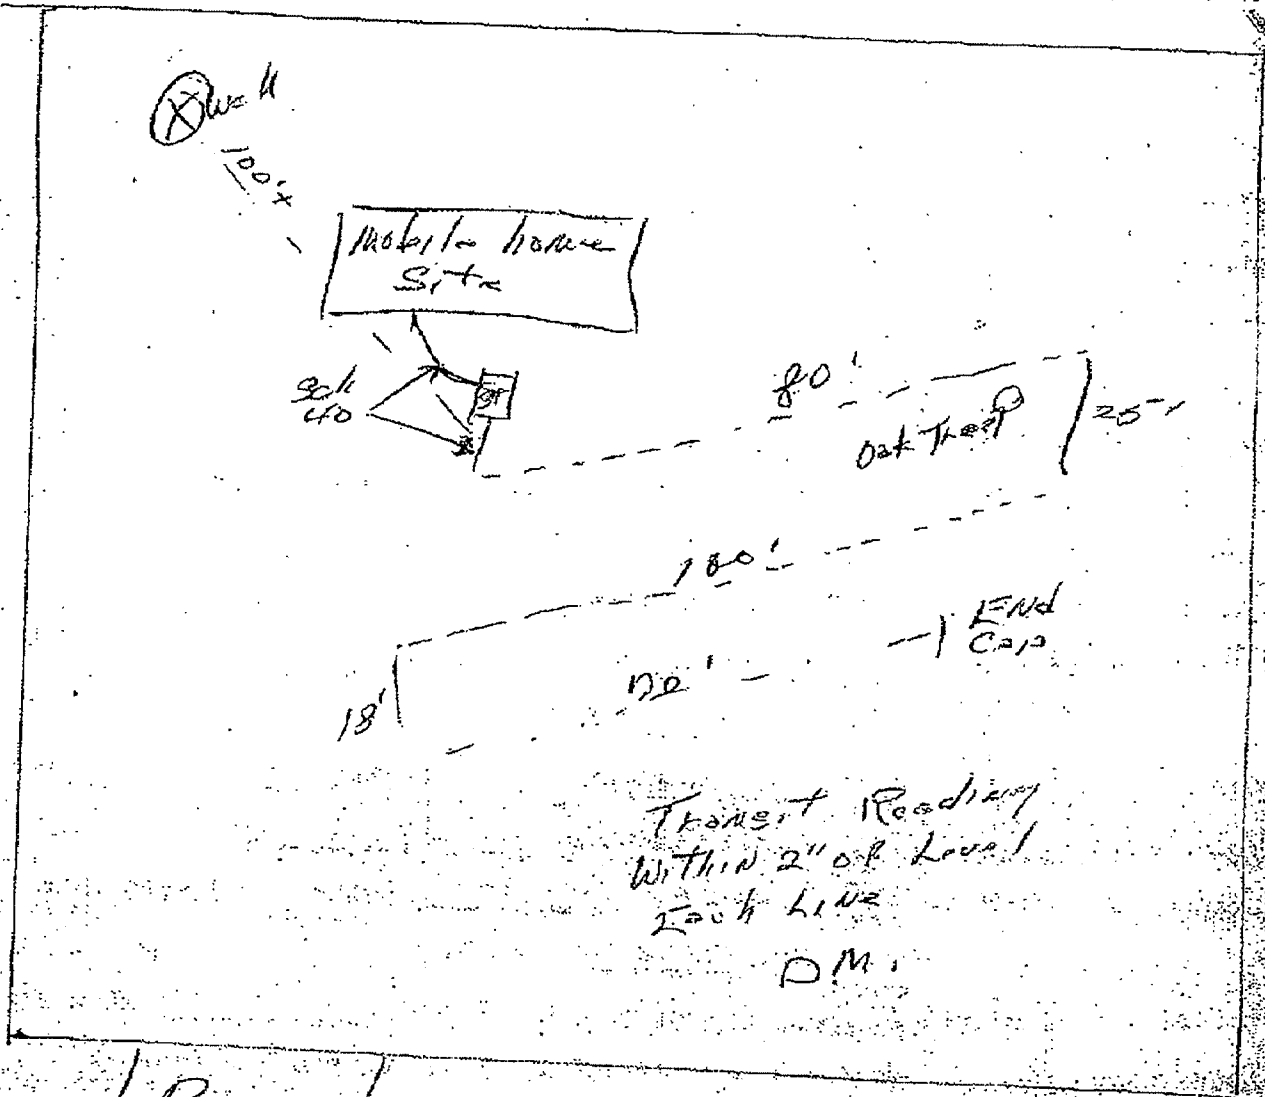
① Note: Copy of this inspection report must be given to owner and the original filed in the Health Department files. PERMANENT RECORD - DO NOT DESTROY.

09-05-'13 10:12 FROM- hamp health dept

3044969650

T-399 P0004

F-405

Bahn

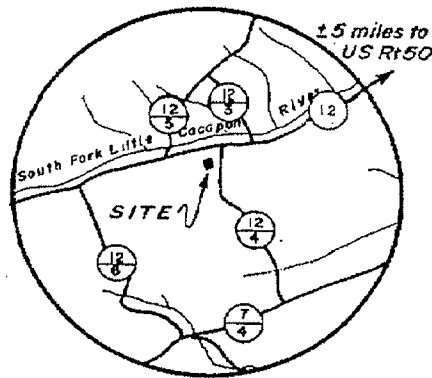
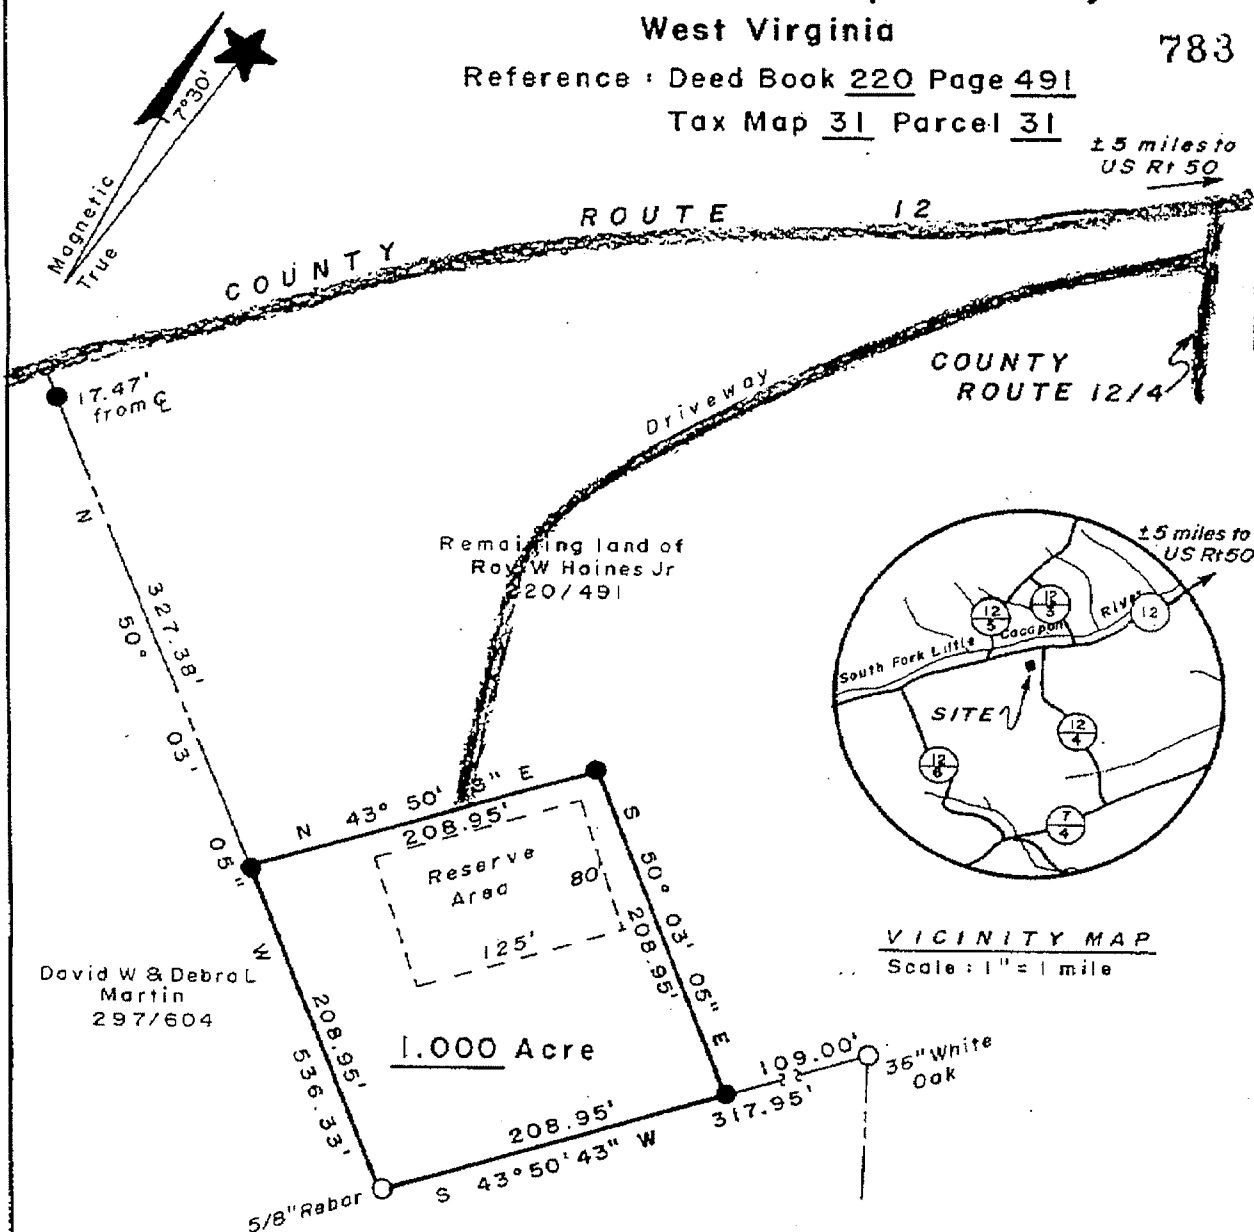
Bearings on this map are magnetic
Compass Declination $7^{\circ}30'$ West
Hampshire Meridian
March 1980 Romney W Va
SCALE: 1" = 200'

Plat of Survey for ROY W HAINES JR

Sherman District • Hampshire County
West Virginia

361

783

Reference: Deed Book 220 Page 491Tax Map 31 Parcel 31± 5 miles to
US Rt 50

VICINITY MAP
Scale: 1" = 1 mile

I CERTIFY THAT:

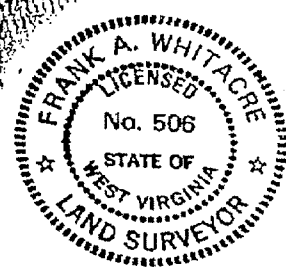
1. This Plat is based on an actual Field Survey made with sufficient accuracy and monumentation to permit reasonable retracement under normal conditions.
2. The Survey and Plat are in accordance with Survey Regulations of the State of West Virginia.
3. The Survey is based on Record Description, is correct, and there are no overlaps encroachments or gaps.
4. All lines are marked and painted where they pass through wooded areas.
5. Any exceptions to the above are shown hereon.

LEGEND

- 5/8" Re-bar with Yellow Plastic Cap Labeled "WHITACRE LLS 506"
- Point in Centerline Road

FRANK A. WHITACRE LLS
HC 74 Box 218A
Romney, W. Va. 26757
Phone: 1-304-822-4606

Frank A. Whitacre



DATE June 16, 1992
Map No. 81-056-G

EXEMPT
From The

Hampshire County Subdivision
ORDINANCE

Date 7/27/92
D. K. Kanne
Hampshire County Planner

STATE OF WEST VIRGINIA, County of Hampshire, to-wit:

Be it remembered that on the 17th day of September, 1992, at 1:36 P M.,
this Deed & Plat was presented in the Clerk's Office of the County Commission of said County
and with the certificate thereof annexed, admitted to record.

Attest *Nancy C. Feller* Clerk
County Commission, Hampshire County, W. Va. *sd.*

CASO & HARRIS INC., SPENCER, W. VA. RE-ORDER NO. 90564F-02

STATE OF WEST VIRGINIA, County of Hampshire, to-wit:

Be it remembered that on the 18th day of October, 1994, at 12:14 P M.,
this Deed & Plat was presented in the Clerk's Office of the County Commission of said County
and with the certificate thereof annexed, admitted to record.

Attest *Nancy C. Feller* Clerk
County Commission, Hampshire County, W. Va. *sd.*

CASO & HARRIS INC., SPENCER, W. VA. RE-ORDER NO. 93956-94