

SS 177 7/96

STATE OF WEST VIRGINIA

INSPECTION TO BE
PRINTED OR TYPED

HEALTH DEPARTMENT

Permit No.: ST-14-06-422Tax Map: 8 Parcel #: 71County: HampshireON-SITE SEWAGE DISPOSAL SYSTEM
INSPECTION FORM

County Road: _____

Name of Owner: Eugene & Peggy Bookwalter Installer: WALTER FIELD
 Address: 7950 FAIR GROUND RD LA PLATA MD 20646
 Property Location: CABIN IN THE PINES LOT #2
 Type of Facility: HOUSE Facility is: New ☒ Existing ☐ Lot Size: 2.5 Sq. Ft./Acres
 Design Loading in gpd/No. Bedrooms: 2 Source of Water Supply: well

SEWAGE TANK COMPONENT

Capacity in Gallons: 1000 Material: concrete Manufacturer: Pyles
 Distances (in feet) of Tank to: Dwelling: 14 Private ☐ Public ☐ Water Source: _____ Property Line: 10+

ON-SITE DISPOSAL SYSTEM

Class I Systems: Standard Soil Absorption Trenches ☐ or Bed ☐ Gravelless Pipe ☐ Diameter: _____ Inches
 Chamber Soil Absorption Trenches ☒ or Bed ☐
 Class II Systems: Pumped/Dosed Soil Absorption Trenches ☐ or Bed ☐ Evapotranspiration Trenches ☐ or Bed ☐
 Shallow Soil Absorption Trenches ☐ or Bed ☐ Other: _____

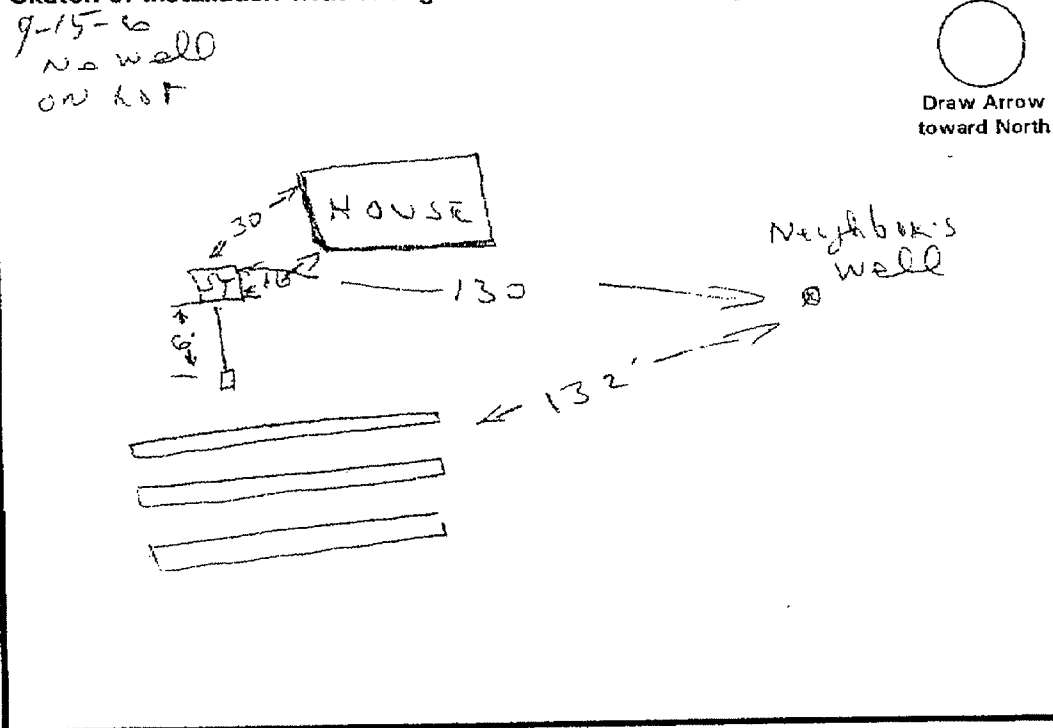
No. of Lines: 3 Length (in feet) of Each: 80, 80, 80
 Width of Trenches: 36 inches/feet Depth to Bottom of Field: 24 inches
 If Bed, Dimensions (in Feet): _____ If Chamber System, Name: INF-5, No. of Units: 48
 Approved and Adequate Materials Used? Yes ☒ No ☐ Size Equates to: 1200 Square Feet of Standard Gravel Field.
 Distances (in feet) of System to: Dwelling: 25 Private ☐ Public ☐ Water Source: _____ Property Line: 10+
 Remarks: _____

An inspection indicates that the sewage disposal system described above
DOES MEET (X),
DOES NOT MEET (),
CANNOT BE DETERMINED TO MEET () the minimum standards established by the West Virginia Bureau of Public Health.

To correct a health hazard, modifications to existing systems may be done to improve part of a system. Such modifications may not be able to be designated as a does meet system since inadequate information is known.

Although many factors contribute to the successful functioning of a sewage disposal system, this office recommends water conservation and maintaining an even usage of water throughout the week.

Sketch of Installation with Triangulation or Distance to Specific Landmarks:

Visit Date(s): 5-15-06Final Inspection Date: 9-15-06Sanitarian: [Signature]