

WEST VIRGINIA  
SEPTIC TANK INSPECTION FORM

Hampshire Health Department Installation Permit No. ST-4-88-205  
Name of Owner Robert and Joyce Reisch  
Address Box 57 Casanova Va, 22017  
Property Address Cacapon River Rec Area PA

DESCRIPTION & NUMBER OF UNITS SERVED

Type Facility Served Home No. Water Closets \_\_\_\_\_  
Lot Size \_\_\_\_\_ sq. ft. Area suitable for sewage disposal installation \_\_\_\_\_ sq. ft.  
Source of Water Supply Genl No. Lavatories \_\_\_\_\_  
No. Bedrooms 2 No. Showers or Tubs \_\_\_\_\_ No. Baths \_\_\_\_\_  
No. Garbage Grinders NO No. Automatic Washers ✓

SEPTIC TANK

Material precast concrete Length \_\_\_\_\_ x Width \_\_\_\_\_ x Depth \_\_\_\_\_ = \_\_\_\_\_ cubic feet  
Liquid Depth \_\_\_\_\_ ft. Liquid Capacity 1000 gal.

Distance to: Dwelling 10 Water Supply \_\_\_\_\_ Nearest Property Line road & river

SOIL ABSORPTION SYSTEM

Type Drain Line Material plastic Trench Width 36 Inches  
Trench Depth 22-26 Inches Total Absorption area in Trench Bottom 600 sq. ft.  
Diameter of Drain Line 4 Inches Type Filter Media gravel  
No. of Drain Lines 3 Depth Filter Media Under Drain Line 6-8 Inches  
Length of Each Line 70, 70, 70 ft. Depth Filter Media Over Drain Line 2 in.  
Distance of Disposal Field to: (a) Dwelling 25-30'  
(b) Water Supply road (c) Nearest Property Line river - 50'

An inspection of the septic tank system described herein disclosed that said system (MEETS, DOES NOT MEET) the minimum standards established by the West Virginia State Department of Health.


12-18-87  
Date

C David Daulton, Jr.  
Sanitarian

SKETCH OF SYSTEM TO BE DRAWN ON BACK

Note: Copy of this inspection report must be given to owner and the original filed in the Health Department files. PERMANENT RECORD - DO NOT DESTROY.

#2A, 13, 14

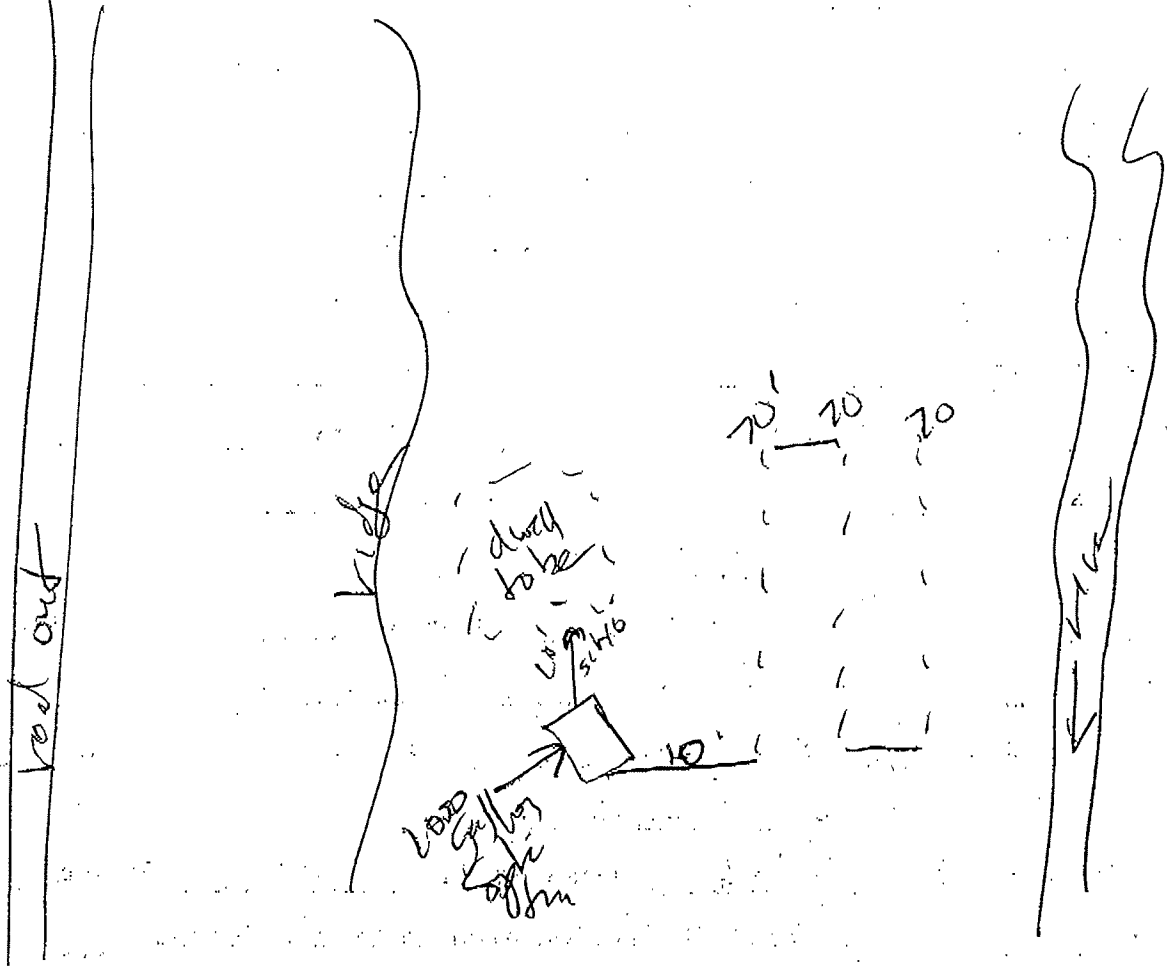

Cladunk PS  
Sanitary