



First American
Title Company


Reference No.: 4331527

County: San Luis Obispo

Location Map

Legend

- PARCEL A
- PARCEL B
- PARCEL C

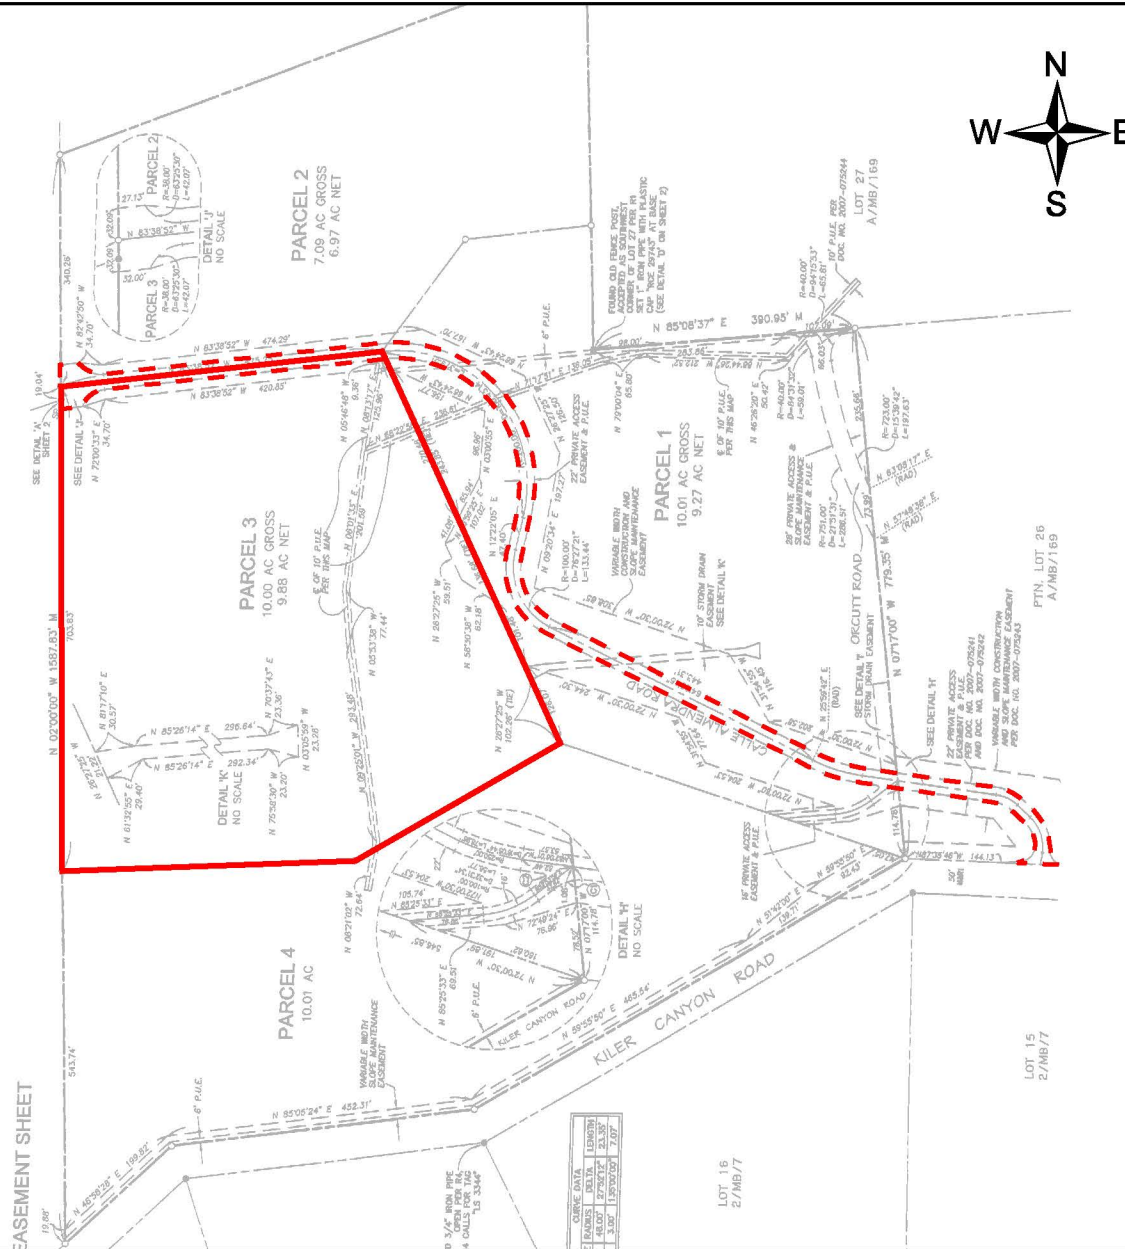

Tax ID: 018-221-010

Short Legal: Parcel 3 Parcel Map # 05-0362 Bk70 Pg52

Map Not
To Scale

This map may or may not be a survey of the land depicted hereon. You should not rely upon it for any purpose other than orientation to the general location of the parcel or parcels depicted. First American Title expressly disclaims any liability for alleged loss or damage which may result from reliance upon this map.



First American
Title Company

Reference No.: 4331527

County: San Luis Obispo

Plotted Easements

Legend



PARCELA



Parcel Map Bk70 Pg52
(Public Utilities)




Parcel Map Bk70 Pg52
(Private Access)



Parcel Map Bk70 Pg52
(Construction & Slope)



11/16/2007 # 2007075242
(Public Utilities)

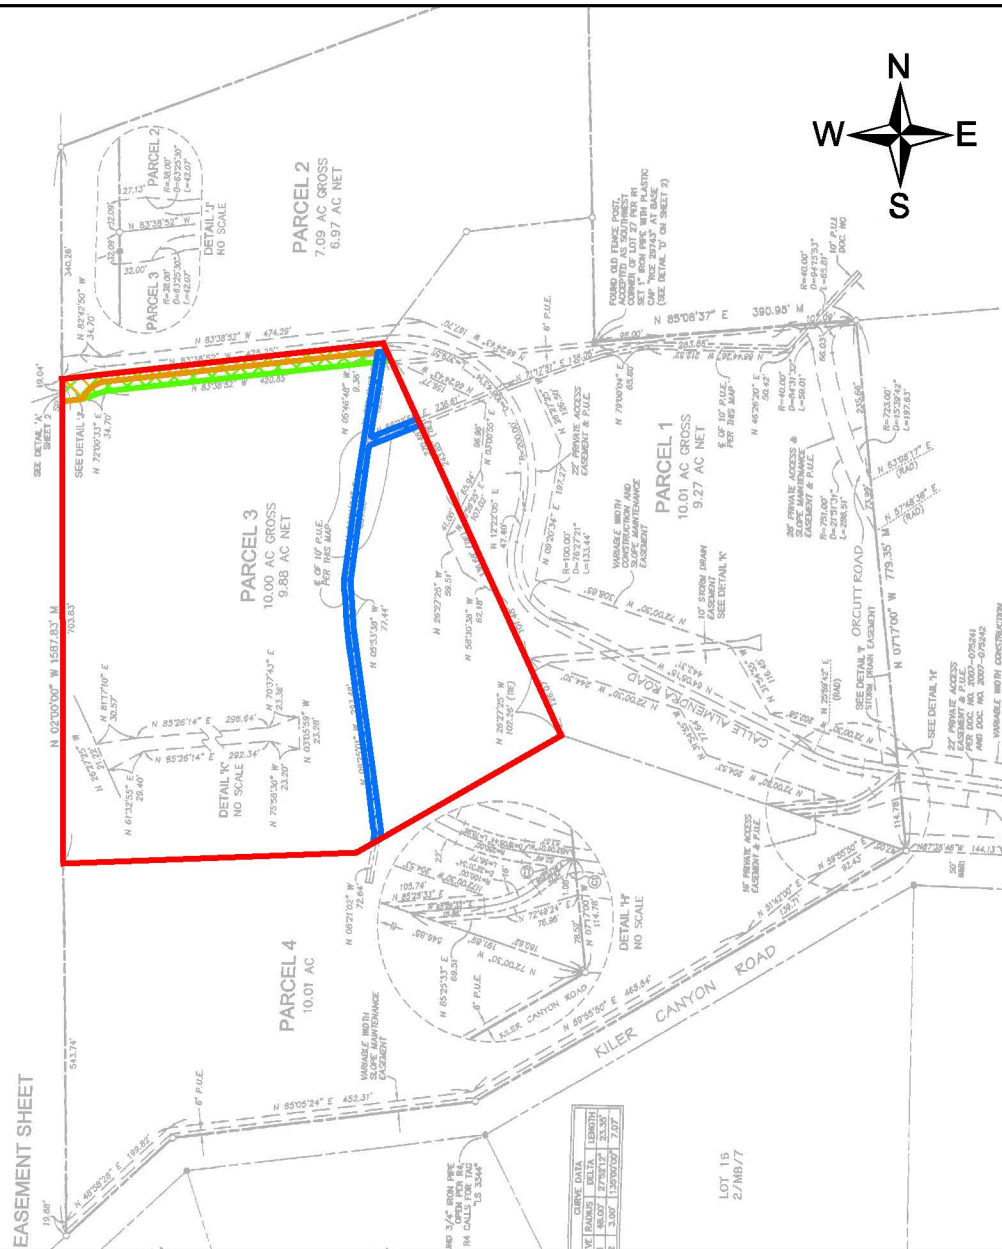

Tax ID: 018-221-010

Short Legal: Parcel 3 Parcel Map # 05-0362 Bk70 Pg52

Map Not
To Scale

This map may or may not be a survey of the land depicted hereon. You should not rely upon it for any purpose other than orientation to the general location of the parcel or parcels depicted. First American Title expressly disclaims any liability for alleged loss or damage which may result from reliance upon this map.

UTILITY LEGEND

- WATER SERVICE
- SEWER LATERAL
- WATER RELIEF VALVE
- SEWER CHY VALVE
- SEWER CLEAN OUT
- CATCH BASIN
- STREET LIGHT
- GAS SERVICE
- WATER VALVE
- CHUCK VALVE IN VAULT
- FIRE HYDRANT ASSY
- BRIST BLOCK
- SEWERMAN MANHOLE
- SANITARY SEWER MANHOLE
- SEWER TELEPHONE POLE
- EXIST POWER POLE
- GAS
- WATER
- PWS HIGH PRESSURE WATER
- SANITARY SEWER
- FORCE MAIN SEWER, ETC NOTED
- STORM DRAIN
- EXISTING TELEPHONE FIBER OPTIC
- EXISTING CABLE TV
- PRIMARY POWER & TELEPHONE

**NOT IN STALLED
OWNER TO INSTAL**

RECORD DRAWING

THESE DRAWINGS ARE BASED ON THE INFORMATION PROVIDED BY OTHERS WITHOUT VERIFICATION. NORTH COAST ENGINEERING INC. ASSUMES NO RESPONSIBILITY FOR THE ACCURACY OR COMPLETENESS OF THIS INFORMATION.

REVISIONS

NO.	BY	DATE	DESCRIPTION
1	ST	1/1/11	REVISIONS

CO 08-0382

COMPOSITE UTILITY PLAN

DESIGNED BY NORTH COAST ENGINEERING INC.

DATE 1/1/11

PROJECT NO. 08-0382

SCALE 1" = 80'

SHEET 8 OF 10

NCE NORTH COAST ENGINEERING INC.

320 Oregon Rd. - Suite B
Paso Robles, CA 93446
(805) 239-3127
(805) 927-8651

*Phone, Electrical and Cable HAS NOT BEEN INSTALLED. Seller advises conduit as noted on map has been installed, but Sellers have not verified and do not know if it is to current PG&E Code. POTENTIAL BUYERS ARE TO VERIFY. Owner of Parcel 4 Pulled power from Kiler Canyon Road.