

SEE CIVIL ACTION
IN RIDGE DRIVE
SIGN.

TO ANY OTHER

FOR CULVERTS,
FRONT SETBACK
AND THE AFORESAID

TS TO CONTACT

3 & 4, THEIR HEIRS

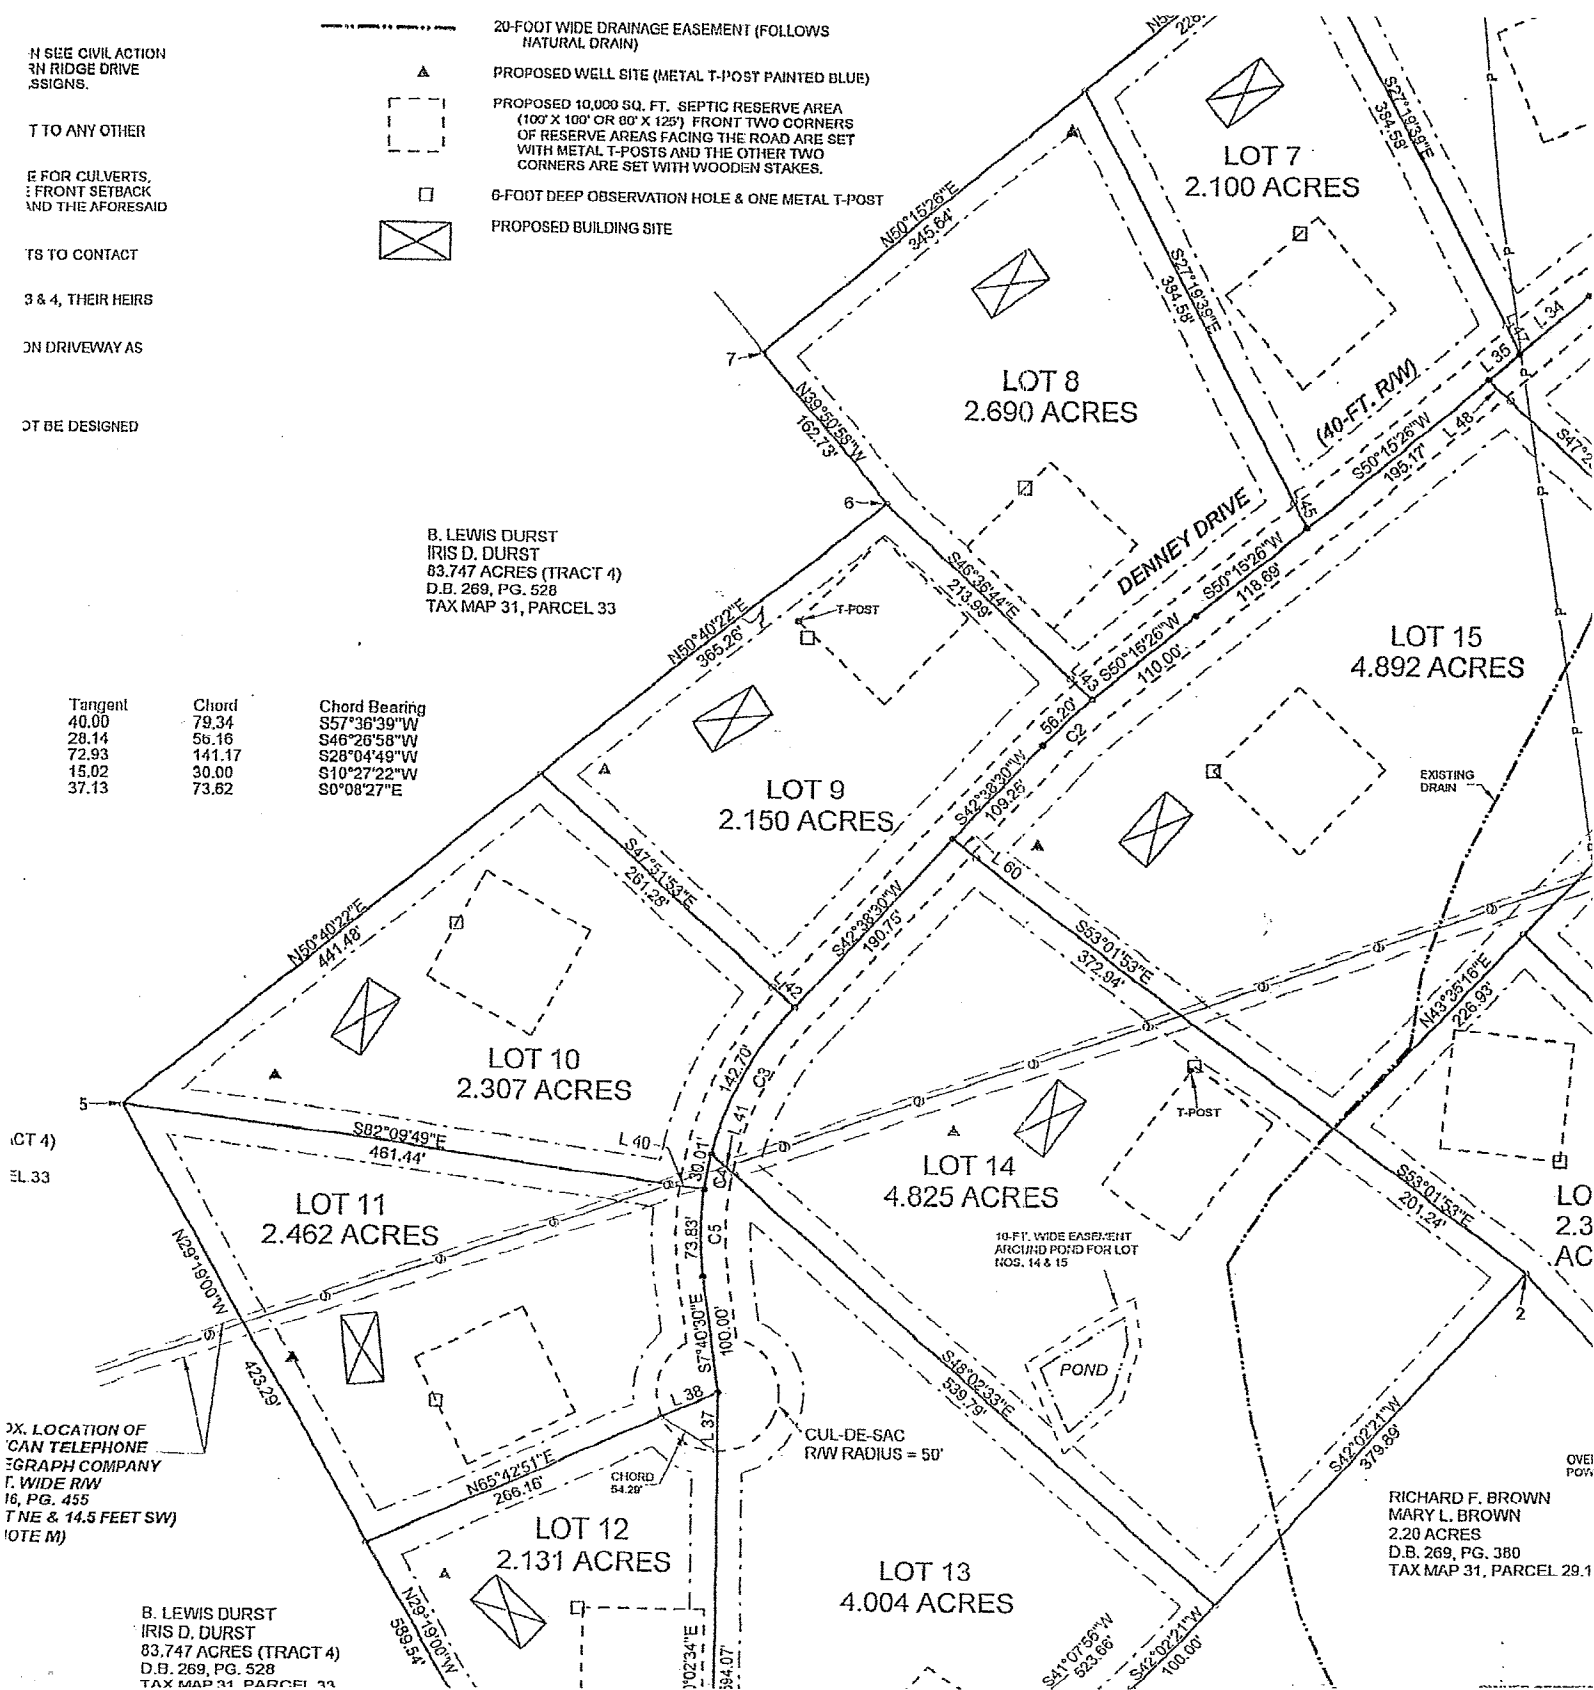
ON DRIVEWAY AS

OT BE DESIGNED

- 20-FOOT WIDE DRAINAGE EASEMENT (FOLLOWS
NATURAL DRAIN)
- PROPOSED WELL SITE (METAL T-POST PAINTED BLUE)
- PROPOSED 10,000 SQ. FT. SEPTIC RESERVE AREA
(100' X 100' OR 80' X 125') FRONT TWO CORNERS
OF RESERVE AREAS FACING THE ROAD ARE SET
WITH METAL T-POSTS AND THE OTHER TWO
CORNERS ARE SET WITH WOODEN STAKES.
- 6-FOOT DEEP OBSERVATION HOLE & ONE METAL T-POST
- PROPOSED BUILDING SITE

B. LEWIS DURST
IRIS D. DURST
83.747 ACRES (TRACT 4)
D.B. 269, PG. 528
TAX MAP 31, PARCEL 33

Tangent	Chord	Chord Bearing
40.00	79.34	S57°36'39"W
28.14	56.16	S46°26'58"W
72.93	141.17	S28°04'48"W
15.02	30.00	S10°27'22"W
37.13	73.62	S0°08'27"E



WV Department of Health and Human Resources
Bureau for Public Health
Office of Environmental Health Services
ENVIRONMENTAL ENGINEERING DIVISION

SW258

Recd 10-22-03

WELL COMPLETION REPORT

Date(s) July 30, 2003 County Hampshire Permit #: _____
Town: Augusta Area Name/Location Blackthorn Lot # 8
Well Owner: Randal & Jeffrey Miller Address: P. O. Box 952
Telephone Number: 304-822-4092 Romney, WV 26757
Well Driller: Miller Bros. Drilling Address: P. O. Box 952
Telephone Number: 304-822-4092 Romney, WV 26757

WELL LOG

DEPTH IN FEET	FORMATIONS: KIND, THICKNESS, AND IF WATER BEARING	REMARKS: Driveshoe
0 - 3	Loose dirt	Type of Well: <u>DW</u> Drilling Method: <u>Air Rotary Hammer</u>
3 - 30	Brown shale	Well Diameter: <u>6"</u> Casing O.D.: <u>6 5/8"</u>
30 - 44	Brown clay	Well Depth: <u>220'</u> Date Completed: <u>July 30, 2003</u>
44 - 50	Blue shale	CASING: Length <u>73</u> Feet Height above ground <u>2</u> Feet
50 - 57	Broken blue shale & water	☒ Steel ☐ Plastic ☐ Cast Iron
57 - 113	Gray shale-consolidated	Other _____ Type _____
113 - 131	Red shale	SCREEN
131 - 149	Gray shale	☒ None Installed
149 - 168	Red shale	Type _____ Diameter _____
168 - 220	Gray shale	Slot/Gauge _____ Length _____
		Set Between _____ Ft. and _____ Ft.

PUMPING OR BAILING TEST

DETAILS	#1	#2	#3
Static Water Level (Ft. Below Grade)			
Pumping Rate (GPM)	60		
Pumping Level (Ft Below Grade)			
Duration of Test (In Hours)			
Recovery Time to Static Level (In Hours)			

WELL HEAD

Pitless Adapter: Type, Make, Etc. _____
Well Cap: Type, Make, Etc. Royer - Conduit type
Well Seal: Type, Make, Etc. _____
Well Platform:
Length _____ Width _____ Thickness _____
pressure
Grouting: ☒ Yes ☐ No
All Public Water Supplies must be grouted.

I hereby certify that this well was drilled and constructed under my supervision, in compliance with all requirements of the referenced permit, and that this record is true to the best of my knowledge and belief.

Jeffrey G. Miller
Name Miller Bros. Drilling Certification No. 255
Registered Business Name _____
Signed [Signature] Date July 30, 2003

INSPECTION TO BE
PRINTED OR TYPED

HEALTH DEPARTMENT

Permit No.: ST-14-02-305

Tax Map: 31 Parcel #: 133

County: HAMPSHIRE

ON-SITE SEWAGE DISPOSAL SYSTEM

County Road: _____

INSPECTION FORM

Name of Owner: BLACKTHORN PARTNERSHIP Installer: Randal Miller
 Address: P.O. Box 952 Romney, WV 26757
 Property Location: BLACKTHORN RIDGE ESTATES LOT #8
 Type of Facility: HOUSE Facility is: New (X) Existing () Lot Size: 2.69 Sq. Ft./Acres
 Design Loading in gpd/No. Bedrooms: 3 BR Source of Water Supply: well

SEWAGE TANK COMPONENT

Capacity in Gallons: 1000 Material: concrete Manufacturer: Jolid
 Distance (in feet) of Tank to: Dwelling: 26 Private (X) Public () Water Source: 90 Property Line: 10'

ON-SITE DISPOSAL SYSTEM

Class I Systems: Standard Soil Absorption Trenches () or Bed () Gravelless Pipe (), Diameter: _____ Inches
 Chamber Soil Absorption Trenches (X) or Bed ()
 Class II Systems: Pumped/Dosed Soil Absorption Trenches () or Bed () Evapotranspiration Trenches () or Bed ()
 Shallow Soil Absorption Trenches () or Bed () Other: _____

No of Lines: 3 Length (in feet) of Each: 80, 80, 80
 Width of Trenches: 36 inches/feet Depth to Bottom of Field: 24-36 inches
 If Bed, Dimensions (in Feet): _____ If Chamber System, Name: Int. 4200, No. of Units: 39
 Approved and Adequate Materials Used? Yes (X) No () Size Equates to 200 Square Feet of Standard Gravel Field.
 Distance (in feet) of System to: Dwelling: 75 Private (X) Public () Water Source: 140 Property Line: 10'
 Remarks: _____

An inspection indicates that the sewage disposal system described above **DOES MEET (X)**, **DOES NOT MEET ()**, **CANNOT BE DETERMINED TO MEET ()** the minimum standards established by the West Virginia Bureau of Public Health.

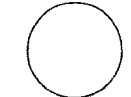
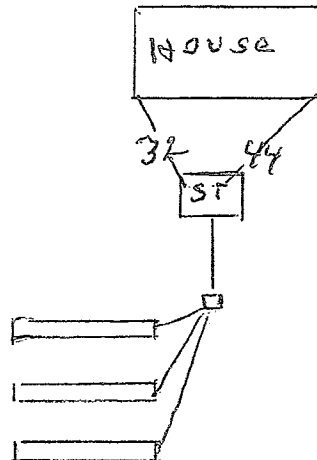
To correct a health hazard, modifications to existing systems may be done to improve part of a system. Such modifications may not be able to be designated as a **does meet** system since inadequate information is known.

Although many factors contribute to the successful functioning of a sewage disposal system, this office recommends water conservation and maintaining an even usage of water throughout the week.

Sketch of Installation with Triangulation or Distance to Specific Landmarks:

Not to Scale

well

Draw Arrow
toward North

Visit Date(s) 4-3-02

Final Inspection Date: 8-20-03

Sanitarian: J. Keith