

T-47 Residential Real Property Affidavit
(May be Modified as Appropriate for Commercial Transactions)

Date: January 28, 2013

GF No. _____

Name of Affiant(s): Ralph Miles Construction

Address of Affiant: 105 W CR 2142, Willis Point, TX 75169

Description of Property: Home on 4.512 Acres
County Van Zandt, Texas

"Title Company" as used herein is the Title Insurance Company whose policy of title insurance is issued in reliance upon the statements contained herein.

Before me, the undersigned notary for the State of Texas, personally appeared Affiant(s) who after by me being duly sworn, stated:

1. We are the owners of the Property. Or state other basis for knowledge by Affiant(s) of the Property, such as lease, management, neighbor, etc. For example, "Affiant is the manager of the Property for the record title owners."); Ralph Miles Construction.

2. We are familiar with the Property and with the improvements located on the Property.

3. We are closing a transaction requiring title insurance and the proposed insured owner or lender has requested area and boundary coverage in the title insurance policy(ies) to be issued in this transaction. We understand that the Title Company may make exceptions to the coverage of the title insurance as the Title Company may deem appropriate. We understand that the owner of the Property, if the current transaction is a sale, may request a similar amendment to the area and boundary coverage in the Owner Policy of Title Insurance upon payment of the promulgated premium.

4. To the best of our actual knowledge and belief, since 6/17/2008 there have been no:
a. construction projects such as new structures, additional buildings, rooms, garages, swimming pools or other permanent improvements or fixtures;
b. changes in the location of boundary fences or boundary walls;
c. construction projects on immediately adjoining property(ies) which encroach on the Property;
d. conveyances, replatting, assessment grants and/or easement dedications (such as a utility line) by any party affecting the Property.

EXCEPT for the following (If None, Insert "None" Below):
addition of 20'x 30' Metal Barn and studio

5. We understand that Title Company is relying on the truthfulness of the statements made in this affidavit to provide the area and boundary coverage and upon the evidence of the existing real property survey of the Property. This Affidavit is not made for the benefit of any other parties and this Affidavit does not constitute a warranty or guarantee of the location of improvements.

6. We understand that we have no liability to the Title Company or the title insurance company that will issue the policy(ies) should the information in this Affidavit be incorrect other than information that we personally know to be incorrect and which we do not disclose to the Title Company.


Ralph Miles

SWORN AND SUBSCRIBED this _____ day of _____,

Notary Public

(TAR-1907) 5-01-08

Page 1 of 1

Buck Ranch P.O. 1443 S. Buffalo Creek, TX 75169
Phone: 903-367-7777 Fax: 903-367-7774

Dobbin Mardock


Ralph Miles Co

Produced with ZipForm® by ZipLogic, 10079 Fifteen Mile Road, Novi, Michigan 48375 www.ziplogic.com

PLAT OF SURVEY

I, Miles H. Bowles, Jr., Registered Professional Land Surveyor No. 4855A, do hereby certify that the past herein was prepared from an as-built survey made by me or under my direct supervision on the ground of the property located on CR 2142, Concho, Texas, and being described as follows: Lot 1a, Section 24, Concho MANGROVES, containing 16.4875± acres. Additions recorded in State 3425-B of the Plat Records, Van Zandt County, Texas.

T. T. HAVINS SURVEY, A-364

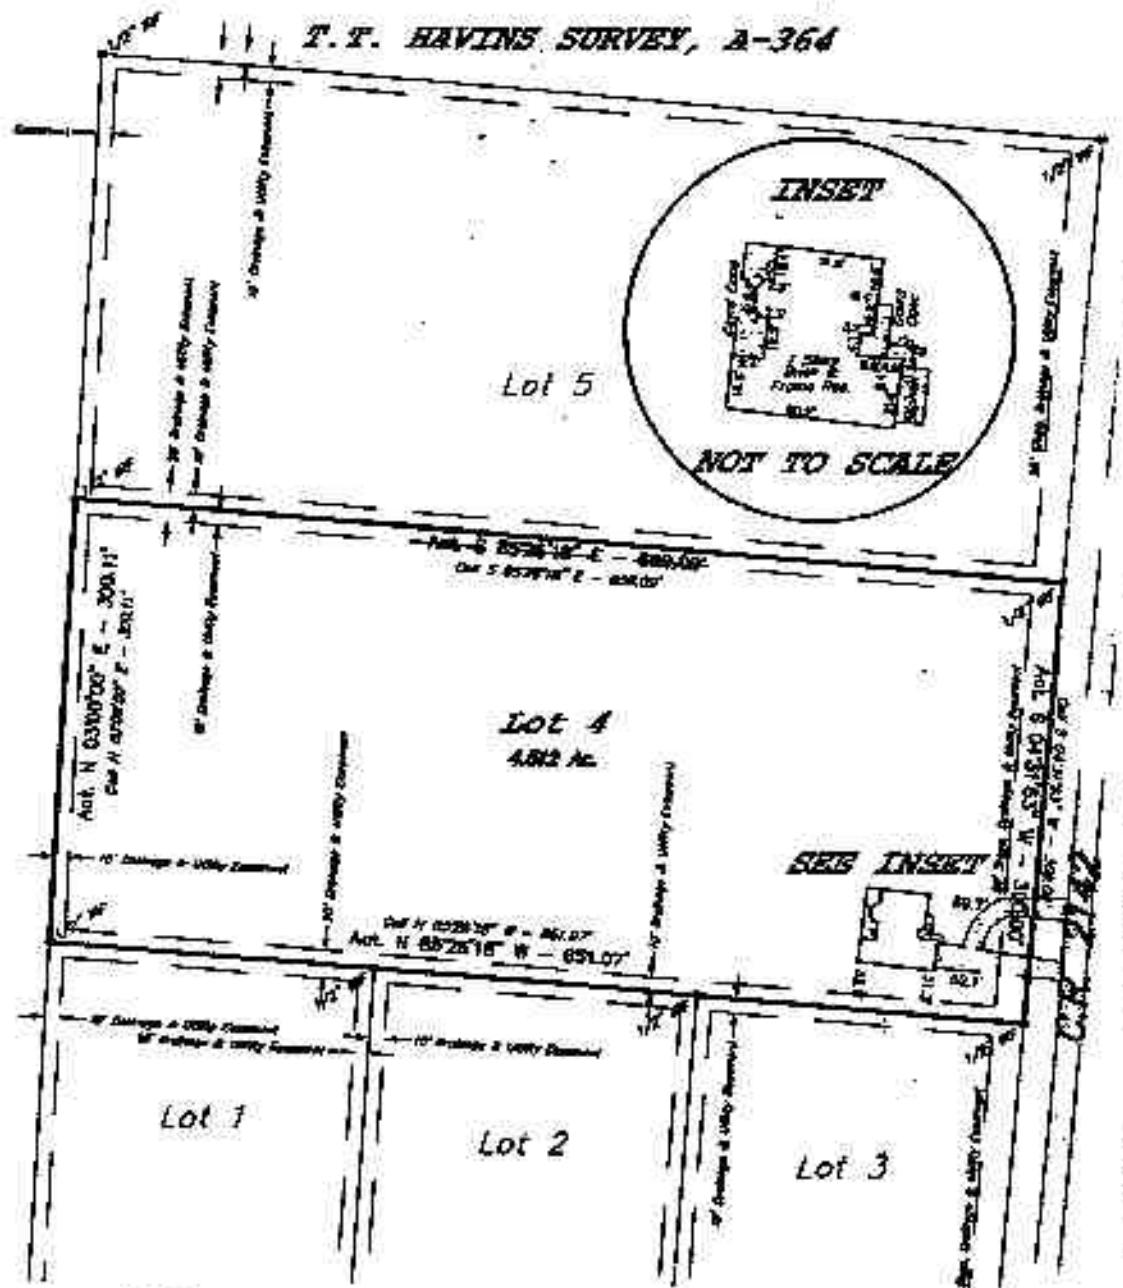

NOTE: Case drill Alkaline batteries are the same.

The bearing support width predicted is agree with the Piso Record cast along the recommended East Line of test 4.

The survey shows lagged 14 day and 28 day transaction times after the buyer and is not valid for use in any other interaction involving the same referenced products.

This survey substitutes a response with the current Texas Society of Professional Surveyors standards, and specifications for a coverage of condition of survey.

Extraneous, sensible, or preexisting, if any, are as shown.

None of this lot appears to be located within a special flood hazard area or above an initial step. Permit No. 401040-0006 R. Effective date: 08-09-1978.

- | LEADER | |
|--------|----------------------------|
| E.P. | Eng. Proj. Leader |
| M.P. | Major Proj. Leader |
| I.S. | Iron Pipe Sales |
| O.P. | Outside Power Pipe |
| E.P. | Electric Poles |
| C.P. | Cable Poles |
| O.T. | Telephone Pole Dept. |
| O.W.E. | Overhead Electric |
| W.M. | Water Meter |
| I.C.V. | Irrigation, Central Valves |
| W.V. | Water Valve |
| F.H. | Fire Hydrant |
| M.W. | Manholes |



SCALE 1" = 100'
DATE 7/3/2008
BOOK/PAGE 222/6
MAP SHEET 100-00-4
G.F. N.H. MILES