

INSPECTION TO BE
PRINTED OR TYPED

STATE OF WEST VIRGINIA

HEALTH DEPARTMENT

Permit No.: ST-14-98-327

County: Hampshire

ON-SITE SEWAGE DISPOSAL SYSTEM
INSPECTION FORM

Tax Map: Parcel #:

County Road:

Name of Owner: Roger Resner Installer: A. Harnes
 Address: P.O. 178 SLANESVILLE WV
 Property Location: Kador Rd. West side of road to end of road
 Type of Facility: House Facility is: New () Existing () Lot Size: 5.25 Acres
 Design Loading in gpd/No. Bedrooms: 2 BR Source of Water Supply: well

SEWAGE TANK COMPONENT

Capacity in Gallons: 1000 Material: concrete Manufacturer: Soler
 Distances (in feet) of Tank to: Dwelling: 9'6" Private () Public () Water Source: 103' Property Line: 100'

ON-SITE DISPOSAL SYSTEM

Class I Systems: Standard Soil Absorption Trenches () or Bed () Gravelless Pipe () Diameter: 10 inches
 Chamber Soil Absorption Trenches () or Bed ()
 Class II Systems: Pumped/Dosed Soil Absorption Trenches () or Bed () Evapotranspiration Trenches () or Bed ()
 Shallow Soil Absorption Trenches () or Bed () Other:


No. of Lines: 3 Length (in feet) of Each: 100, 100, 100
 Width of Trenches: 24 inches/feet Depth to Bottom of Field: 24 inches
 If Bed, Dimensions (in Feet): If Chamber System, Name: No. of Units:
 Approved and Adequate Materials Used? Yes () No () Size Equates to: 900 Square Feet of Standard Gravel Field.
 Distances (in feet) of System to: Dwelling: 9' Private () Public () Water Source: 120' Property Line: 100'
 Remarks:

An inspection indicates that the sewage disposal system described above
DOES MEET ()
DOES NOT MEET ()
CANNOT BE DETERMINED TO MEET () the minimum standards established by the West Virginia Bureau of Public Health.

To correct a health hazard, modifications to existing systems may be done to improve part of a system. Such modifications may not be able to be designated as a does meet system since inadequate information is known.

Although many factors contribute to the successful functioning of a sewage disposal system, this office recommends water conservation and maintaining an even usage of water throughout the week.

Sketch of Installation with Triangulation or Distance to Specific Landmarks:

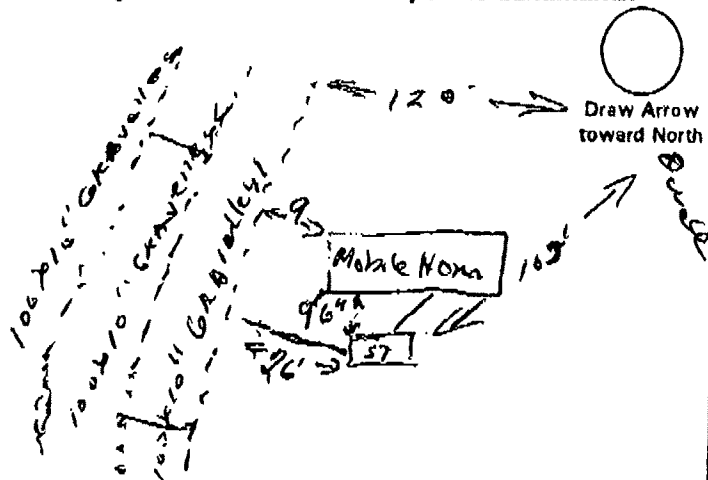

Visit Date(s): 6-2-98
 Final Inspection Date: 2-2-98

Sanitarian: J. E. Under R. S.

WELL COMPLETION REPORT

Date(s) 4-15-98-4-15-99 County Hampshire Permit #: DW-14-98-188
Town: Shenandoah W Va Area Name/Location _____
Well Owner: Regu Kessner Address: P.O. Box 133J
Telephone Number: _____ Buckley Springs W Va
Well Driller: Regu T De Haven Address: 250 Well Driller Ln
Telephone Number: 722.3300 Wernchester Va 22603

WELL LOG

DEPTH IN FEET	FORMATIONS: KIND, THICKNESS, AND IF WATER BEARING	REMARKS:
0-17	Shale	Type of Well: <u>WATER</u> Drilling Method: <u>AIR HAMMER</u>
17-300'	Red Slate	Well Diameter: <u>6"</u> Casing O.D.: <u>6 5/8</u>
WATER AT	275-278 106pm	Well Depth: <u>300'</u> Date Completed: <u>6/30/98</u>
		CASING: Length <u>21</u> Feet Height above ground <u>1</u> Feet
		☒ Steel ☐ Plastic ☐ Cast Iron
		Other _____ Type _____
		SCREEN
		☒ None Installed
		Type _____ Diameter _____
		Slot/Gauge _____ Length _____
		Set Between _____ Ft. and _____ Ft.

PUMPING OR BAILING TEST

DETAILS	#1	#2	#3
Static Water Level (Ft. Below Grade)			
Pumping Rate (GPM)	10		
Pumping Level (Ft Below Grade)			
Duration of Test (In Hours)			
Recovery Time to Static Level (In Hours)			

WELL HEAD

Pitless Adapter: Type, Make, Etc. _____
Well Cap: Type, Make, Etc. _____
Well Seal: Type, Make, Etc. _____
Well Platform:
Length _____ Width _____ Thickness _____
Grouting: ☒ Yes ☐ No BENSEAL 1 BAG
All Public Water Supplies must be grouted.

I hereby certify that this well was drilled and constructed under my supervision, in compliance with all requirements of the referenced permit, and that this record is true to the best of my knowledge and belief.

Regu T De Haven 021
Name Certification No.
Regu T De Haven Well Driller Inc
Registered Business Name
Regu T De Haven 6-30-98
Signed Date