

PERMIT
PRIVATE SEWAGE DISPOSAL SYSTEMNUMBER SSN-BC-10-00509 DATE 04/272010

BREMER COUNTY BOARD OF HEALTH

TITLE HOLDER: Name: Eileen StummePROPOSED ADDRESS 1356 Larrabee Avenue - TripoliPARCEL NUMBER 040-02-23-400-002-00 23-93-13 NE SECONTRACTOR: Liddle- EbertLot size X Number of family units 1 Number of occupants Bedrooms 4 Laundry Dishwasher G.Disposal W Softener WhirlPool Does dwelling have basement Basement drained by gravity Sump Pump

SOIL LOADING RATE:

Type of soil Location: BASEMENT DRAIN DISCHARGES TO: Septic tank Leaching pit Other place DISTANCE OF PROPOSED SYSTEM FROM WELL: NEEDS TO BE 100'

SEWER LINE FROM DWELLING TO SEPTIC TANK:

Cast iron Vitrified clay or concrete P.V.C. (list weight) SEPTIC TANK: 1250 gal tankConstruction material Compartments Manufacturer Effective capacity below water line LAT: 42° LONG: -92°Soil Absorption: Type Depth of Tile Depth of gravel below tile Depth of gravel over tile

ALTERNATE SYSTEMS: Connecting the home to Septic system that was installed in "94" for a trailer. The trailer is gone

See attached

No guarantee is intended or implied by reason of any advice given by the Board of Health or its staff.

It is the responsibility of the property owner to insure all necessary manhole covers are secure to prevent unauthorized access. The property owner is responsible to properly maintain all private on-site sewage treatment systems. When the combined sludge in the bottom and the floating scum thickness in the septic tank is equal to $\frac{1}{4}$ to $\frac{1}{3}$ of the liquid depth, the sludge must be removed and disposed of by a licensed scavenger.

The local Board of Health may require a connection to a public sewer when one becomes available in the future.

I certify that all proposed work will be completed in accordance with the Bremer County regulations before the facilities are placed in operation.

Signature of Applicant: _____

Date

4-29-10

Date of Preliminary Approval

5-24-10


Date of Final Approval

City Approval Where Applicable

Representing Bremer County Board of Health

Representing Bremer County Board of Health

North

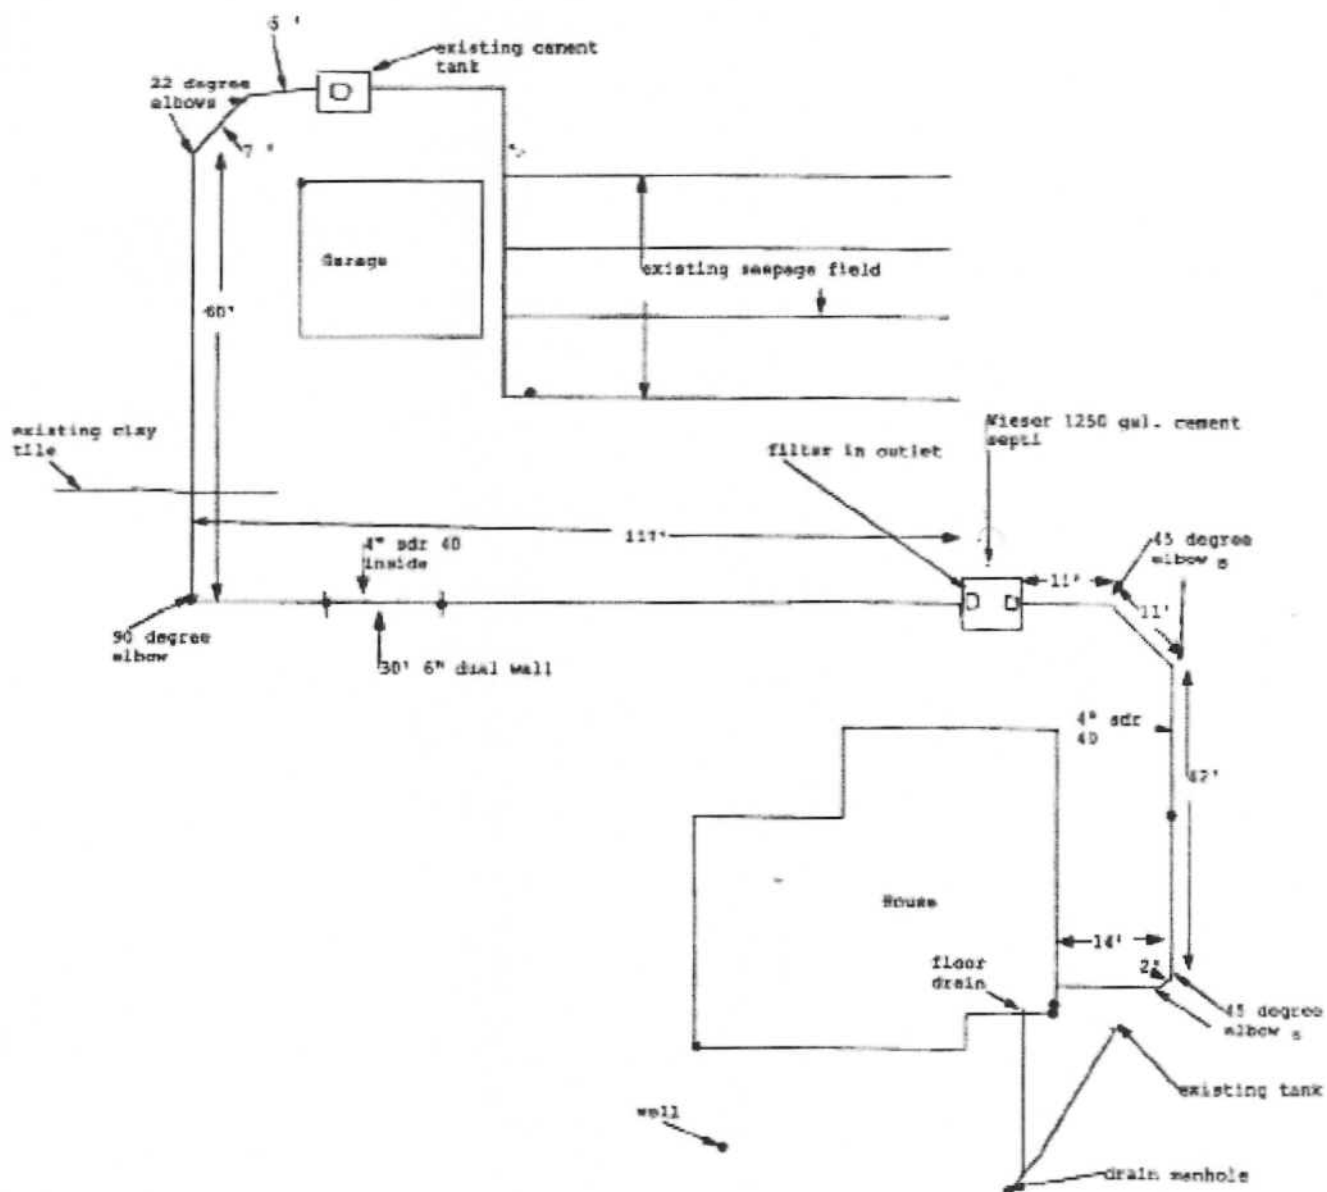

Customer: Eileen Stumme

Location: 1356 Larrabee Ave. Tripoli

Scale: 20 feet

Spacing: variable

Date: May 24-25, 2010

Little-Ebert Ltd. Farm Drainage