

Permit # ST-14-12-49


SEWAGE TANK COMPONENT

ON-SITE DISPOSAL SYSTEM

GPS: N39 11 16.0 W78 41 55.4

Visit Date(s) : 12/22/2011

SANITARIAN:

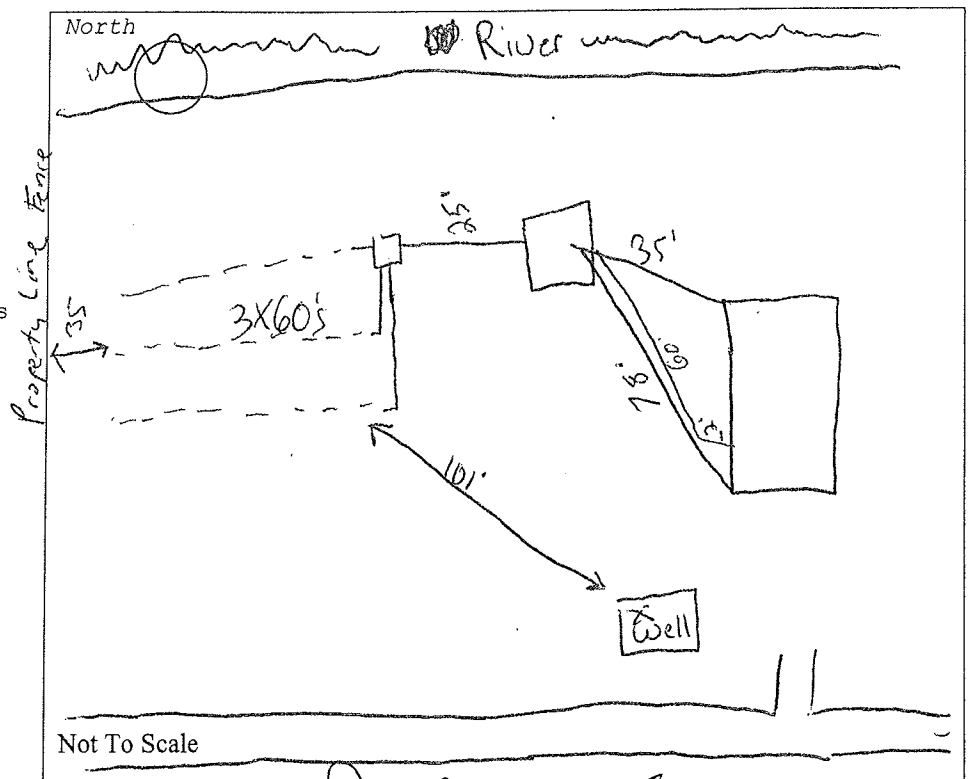

STATE OF WEST VIRGINIA

HAMPSHIRE COUNTY HEALTH DEPARTMENT

ON-SITE SEWAGE DISPOSAL SYSTEM PERMIT

Owner: Kevin & Amanda Blank
 Address: PO Box 536, Springfield, WV 26763
 Installer: Benjamin Smith
 Address: Rt. 1 Box 164, Keyser, WV 26726

You are hereby issued a permit to: install an on-site sewage disposal system located at:
Bazzle Lots 1,2,3

Tax District Tax Map 0 Parcel # 8,9,10

Facility: Existing Design Flow: 2 Lot Size: 30,000 sq ft Acres Water Source: Well
 BASED UPON REVIEW OF THE INFORMATION OF YOUR SUBMITTED APPLICATION, DATED 12/7/2011, AND
 THE PROPER INSTALLATION OF THE HERIN DESCRIBED SYSTEM, THE SYSTEM SHALL BE IN COMPLIANCE
 WITH APPLICABLE WEST VIRGINIA SEWAGE SYSTEM RULES AND DESIGN STANDARDS.

The sewage system shall consist of a:

- ☒ Septic tank—Capacity: 1000 gallons or more, Constructed of precast concrete.
☒ Soil disposal system with a minimum equivalency of 900 sq ft of conventional gravel trench area.
 Depth to the bottom of the trench installation shall be: 24 inches from original ground surface. Width 36 inches.
☐ Gravel system: Number of Lines: _____ Length of lines: _____
☒ Chamber system: Number of Lines: 3 Length of lines: 60's
☐ Class II System: _____
☐ Other: _____

GPS Coordinates: North 39 11 16.0 West 78 41 55.4

This permit is non-transferable and
 Automatically expires 12 months
 After issue date.

This permit is NULL and VOID
 When official inspection reveals
 Conditions different than those
 Stipulated on the permit or facts
 Are later found that would indicate
 non-compliance with applicable
 rules.

**All systems must be inspected
 And approved prior to being
 Covered with earth or placed
 into use.**

***The applicant or his agent must
 Notify this department 72 hours
 Or more prior to planned
 Inspection time.***

Issue date


12/20/2011

(304) 496-9641

County Office Phone Number

Sketch of systems:

Draw Arrow Toward North

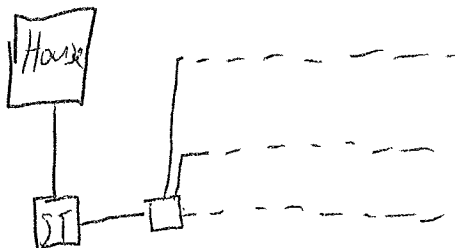

10, 000 Sq ft Reserve area REQUIRED

Schedule 40 Pipe Required

NOT TO SCALE

Devon H. Hays
 Health Officer or Sanitarian