

WV STATE DEPARTMENT OF HEALTH
Office of Environmental Health Services
ENVIRONMENTAL ENGINEERING DIVISION

SW258

*Filed
8.23.88*

WELL COMPLETION REPORT

Date(s) 8/8-18/88 County Hampshire Permit #: DW-14-08-89-57
Town: _____ Area Name/Location Buffalo Ridge Ranchettes Lot 81
Well Owner: Gene Bis Address: 25 Acorn Circle
Telephone Number: 856-2762 / 301-9640 Towson Md. 31204
Well Driller: B. Mark Smith Address: Star Rt Box 2-A
Telephone Number: 304-822-4786 Springfield WV 26763

WELL LOG

DEPTH IN FEET	FORMATIONS: KIND, THICKNESS, AND IF WATER BEARING	REMARKS:
0-38	Clay	4" pvc liner installed entire length of well. perforated from 165' to 185'
39-45	Soft Shale	Type of Well: <u>home</u> Drilling Method: <u>Cable-Tool</u>
46-50	Gravel	Well Diameter: <u>6 1/8"</u> Casing O.D.: <u>6 5/8"</u>
51-65	hard shale	Well Depth: <u>232</u> Date Completed: <u>8/18/88</u>
66-110	hard limestone / shale	CASING: Length <u>55</u> Feet Height above ground _____ Feet
111-115	Gravel	<input checked="" type="checkbox"/> Steel <input type="checkbox"/> Plastic <input type="checkbox"/> Cast Iron
116-168	hard limestone / shale + clay	Other _____ Type _____
169-173	fractured limestone water	SCREEN
174-185	hard limestone	<input checked="" type="checkbox"/> None Installed
186-232	Soft Shale + Clay	Type _____ Diameter _____
	1800 Gph.	Slot/Gauge _____ Length _____
		Set Between _____ Ft. and _____ Ft.

PUMPING OR BAILING TEST

DETAILS	#1	#2	#3
Static Water Level (Ft. Below Grade)	<u>166</u>		
Pumping Rate (GPM)	<u>30</u>		
Pumping Level (Ft Below Grade)	<u>166</u>		
Duration of Test (In Hours)	<u>1</u>		
Recovery Time to Static Level (In Hours)	<u>0</u>		

Additional pump test will be made.

I hereby certify that this well was drilled and constructed under my supervision, in compliance with all requirements of the referenced permit, and that this record is true to the best of my knowledge and belief.

WELL HEAD

Pitless Adapter: Type, Make, Etc. To be installed
Well Cap: Type, Make, Etc. Royer
Well Seal: Type, Make, Etc. _____
Well Platform: _____
Length _____ Width _____ Thickness _____
Grouting: ☒ Yes ☐ No
All Public Water Supplies must be grouted. portland type II

B. Mark Smith 001
Name B.W. Smith Well Drilling Certification No. _____
Registered Business Name _____
Signed [Signature] Date 8/18/88

SS-177

Revised 1-71

WEST VIRGINIA
SEPTIC TANK INSPECTION FORM

66 North High Street

Romney, West Virginia

Health Department

Installation Permit No.

ST-14-85-117

Name of Owner

G. E. VA B. S.

Address

25 Arion Circle Apt 103 Romney, Wd 26204

Property Address

Buffalo Ridge Ranch Lot 87

DESCRIPTION & NUMBER OF UNITS SERVED

Type Facility Served

New Cabin

No. Water Closets

Lot Size

8,000 sq. ft.

Area suitable for sewage disposal installation

sq. ft.

Source of Water Supply

Johanna well

No. Lavatories

No. Bedrooms

2

No. Showers or Tubs

No. Baths

No. Garbage Grinders

NO

No. Automatic Washers

✓

SEPTIC TANK

Material

p. 111

Length

x Width

x Depth

=

cubic feet

Liquid Depth

ft.

Liquid Capacity

1,000

gal.

Distance to:

Dwelling 30

Water Supply

Johanna well

Nearest Property Line

road

SOIL ABSORPTION SYSTEM

Type Drain Line Material

plastic

Trench Width

36

Inches

Trench Depth

30

Inches

Total Absorption area in Trench Bottom

510

sq. ft.

Diameter of Drain Line

4

Inches

Type Filter Media

gravel (18 in)

No. of Drain Lines

2

Depth Filter Media Under Drain Line

6.8

Inches

Length of Each Line

100, 70

ft.

Depth Filter Media Over Drain Line

2 in.

Distance of Disposal Field to:

(a) Dwelling

410'

(b) Water Supply

Johanna well

(c) Nearest Property Line

road

An inspection of the septic tank system described herein disclosed that said system (MEETS, DOES NOT MEET) the minimum standards established by the West Virginia State Department of Health.

Date

9-13-85


Sanitarian

David Dunlap RS

SKETCH OF SYSTEM TO BE DRAWN ON BACK

Note: Copy of this inspection report must be given to owner and the original filed in the Health Department files. PERMANENT RECORD - DO NOT DESTROY.

81

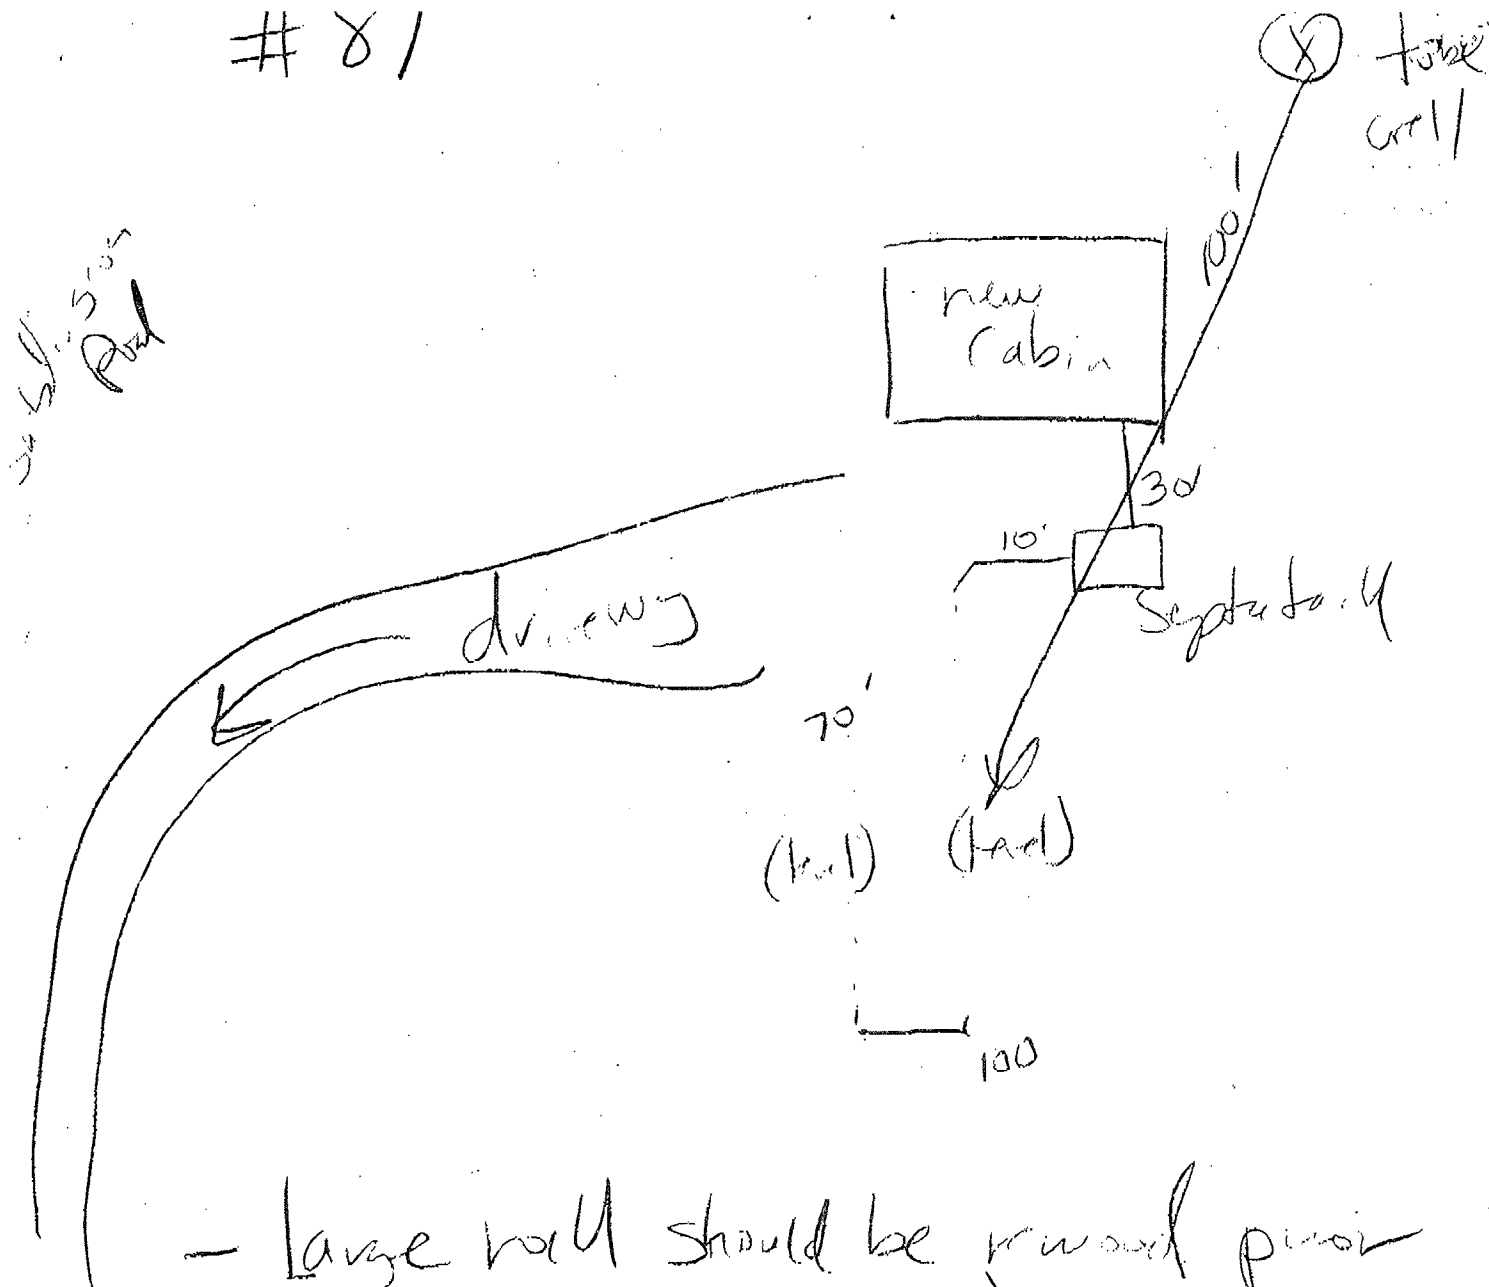

David Dwyer PS,
San Antonio