

ALABAMA DEPARTMENT OF PUBLIC HEALTH
PERMIT TO INSTALL (Repair) AN ONSITE SEWAGE DISPOSAL SYSTEM

Clair County Health Department: 187608 County Health Department I.D. No.

For Department Use Only
 New Repair Alternative Other
This permit: APPROVED With Conditions (See Below) NOT APPROVED
Reasons: _____

APPLICANT: Ronnie Lockhart Telephone: _____
Address/Location: 3525 Mountain View Road Claytonville, AL
Deerfoote Lane State _____ Zip _____
SUBDIVISION (if applicable): N/A Plat _____ Block _____ Lot _____


- INSTALL AT THIS SITE: An approved onsite sewage disposal system constructed in compliance with the Onsite Sewage Disposal Rules (Chapter 420-3-1) and the approved plot/construction plan.
1. SEPTIC TANK: 1000 gallons (minimum) Other _____
 2. EFFLUENT DISPOSAL FIELD: 332 square feet consisting of (as appropriate):
 - 184 Linear feet installed in a 36 inch wide trench, and at a depth of 2 inches.
 - 276 Linear feet of () 10 inch gravel-less pipe.
 - _____ Linear feet of () for separate washing machine line (Install balance on main disposal field).
 - _____ Linear feet added to total if spa/hot tub installed.
- TOTAL Linear feet in onsite sewage disposal system: _____

ADDITIONAL APPROVAL CONDITIONS: stay off slopes or where there are trees
25% stay at 1000 gal expansion tank provided
old 600 gal tank
04/05/06 Date Issued
 _____ Signature Public Health Environmentalist

APPROVAL FOR USE OF AN ONSITE SEWAGE DISPOSAL SYSTEM

System was installed in compliance with requirements of original permit, or actual installation consists of: _____ gallon tank _____ inch wide washing machine effluent line) _____ linear feet x _____ inch wide _____ inch wide effluent line)

Sketch Location of Disposal System in Relation to House/Building and Well

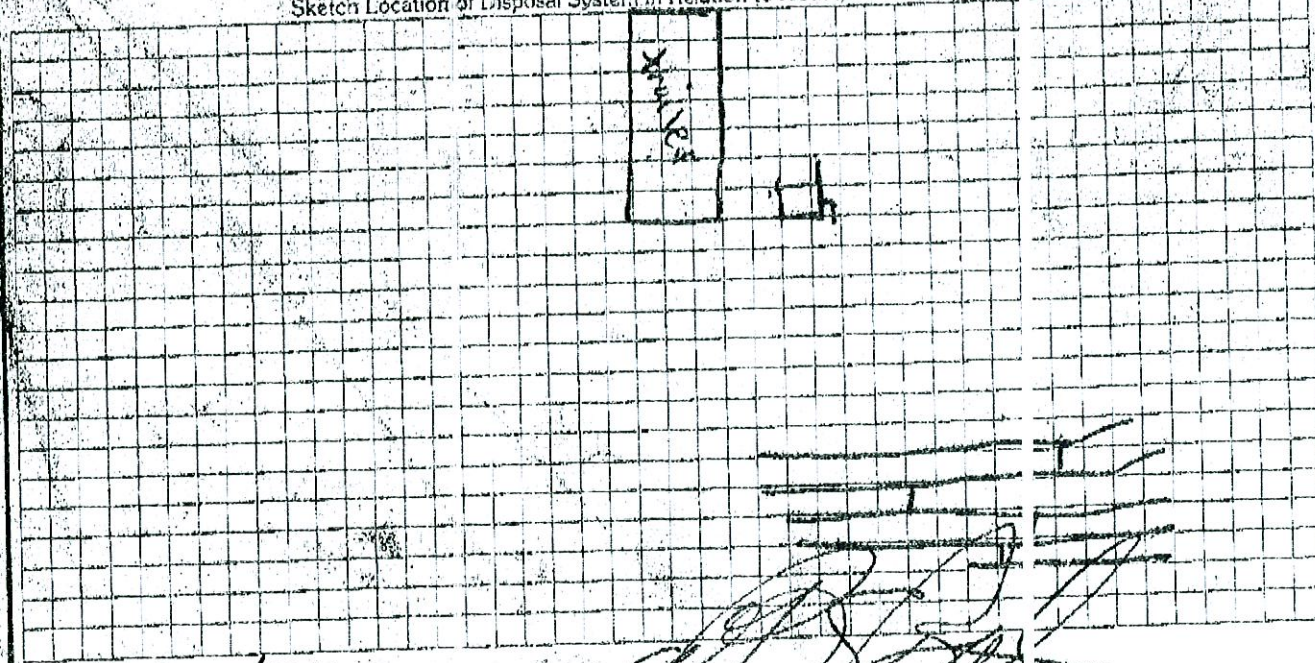

04/29/06
Date Approval for Use Issued

Signature Public Health Environmentalist

The issuance of an Approval for Use does not imply or guarantee that the onsite sewage disposal system will function for any specific period of time.

SPECIAL CONDITIONS (See Attached)

APPROVAL FOR USE