


98-23340

BUNCOMBEE COUNTY HEALTH DEPARTMENT - ENVIRONMENTAL HEALTH SERVICES (704-255-5600)
~~AUTHORIZATION TO CONSTRUCT~~ A SUB-SURFACE SEWAGE DISPOSAL SYSTEM IN A ~~MOBILE HOME PARK~~
~~SPACE #12~~ OPERATIONS PERMIT RKR

Property Owner: DAVID A. & HELEN C. YOUNG Application Date: 4/1/98
 Mailing Address: _____
 Property Location: Road Name: HENSLEY RD Directions: JUPITER RD RT. ON ROBERTS RD
RT ON HENSLEY RD LT AT END
 Park Name: _____ PIN#: 973504-82-1045
 Water Supply: Municipal _____ Well ☒ (Shared _____ Individual ☒ In Place Y or (N) OTHER _____

SECTION ONE: SITE EVALUATION System Design for: New System ☒ Repair _____ Residential ☒ Commercial _____
 Single Unit ☒ Multiple Units _____ No. Units _____ No. Bedrooms per unit 4
 Basement(s): Yes _____ No _____ Basement Plumbing: Yes ☒ No _____
 Permanent Foundation(s) ☒ Mobile(s) _____ Singlewide _____ Doublewide _____
 Available Space: _____ Site Classification: _____ Soil Group: _____
 LTAR: _____ Design Flow: _____
 Type of System: (1) Prefabricated Panel Block _____ (4) Conventional _____
 recommended (2) Large Diameter Pipe _____ (5) Chamber ☒
 (3) Expanded Polystyrene Aggregate _____ (6) Other _____

INSTALLER: MOUNTAIN MOVING
CONSTRUCTION CO.

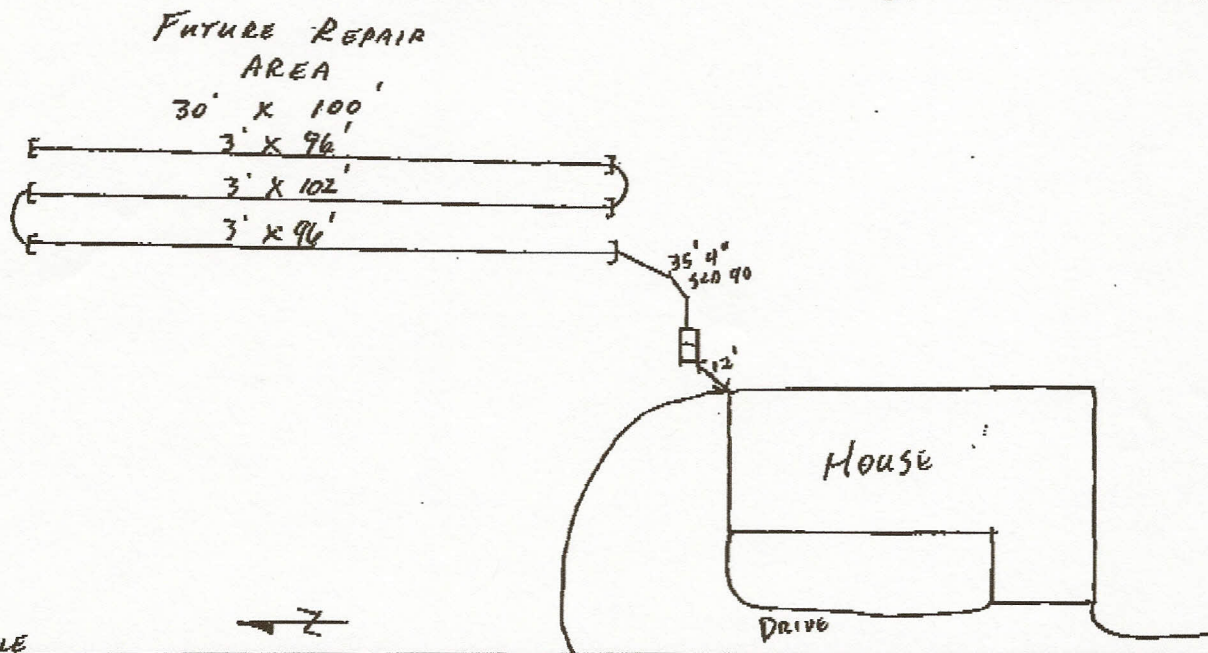

SECTION TWO: Type of System (#) CHAMBER Liquid Capacity of Tank 1000 No. of Trenches 3
 DESIGN Trench Length 300 Trench Width 3 Trench Spac/OC 9'
 Max Trench depth (uniform and on contour) _____ in. on lower sidewall _____
 Distribution: Equal _____ Serial ☒ Stone Depth N/A Dams/Step Downs 2
 Pump Tank Capacity _____ Distance Between Well and System 7100
 Comments: PUMP ST EVERY 3-5 YEARS. KEEP ALL SURFACE GUTTER & FOUNDATION
DRAINS OFF DRAINFIELD AREAS

☐ This document includes all pertinent information applicable to an IMPROVEMENT PERMIT and shall be considered as such by the applicant. If the system is not installed within five years, applicant must apply for a new Authorization to Construct.

☐ Improvement Permit issued prior to this date. Date of Issuance: _____

This document authorizes the property owner to construct a _____ ground Absorption Sewage Disposal System. The owner MAY CONSIDER installing other types of systems listed in SECTION ONE above. Changes from the above shall require Health Department approval. This Authorization to Construct is subject to revocation if the site plan is altered or the intended use changes from those indicated. The installer of this system must have a copy of this document on site during all phases of the installation and final inspection.

Evaluated By: Dpt KRL/RS Date: 10/30/98
 Owner/Agent: David Young Date: _____