


THIS SURVEY IS BEING PROVIDED SOLELY FOR THE USE OF THE CURRENT PARTIES AND THAT NO LICENSE HAS BEEN CREATED, EXPRESSED OR IMPLIED TO COPY THE SURVEY EXCEPT AS IS NECESSARY IN CONJUNCTION WITH THE ORIGINAL TRANSACTION AND IS CERTIFIED FOR THIS TRANSACTION ONLY. PLAT VOID IF NOT SIGNED IN RED INK.

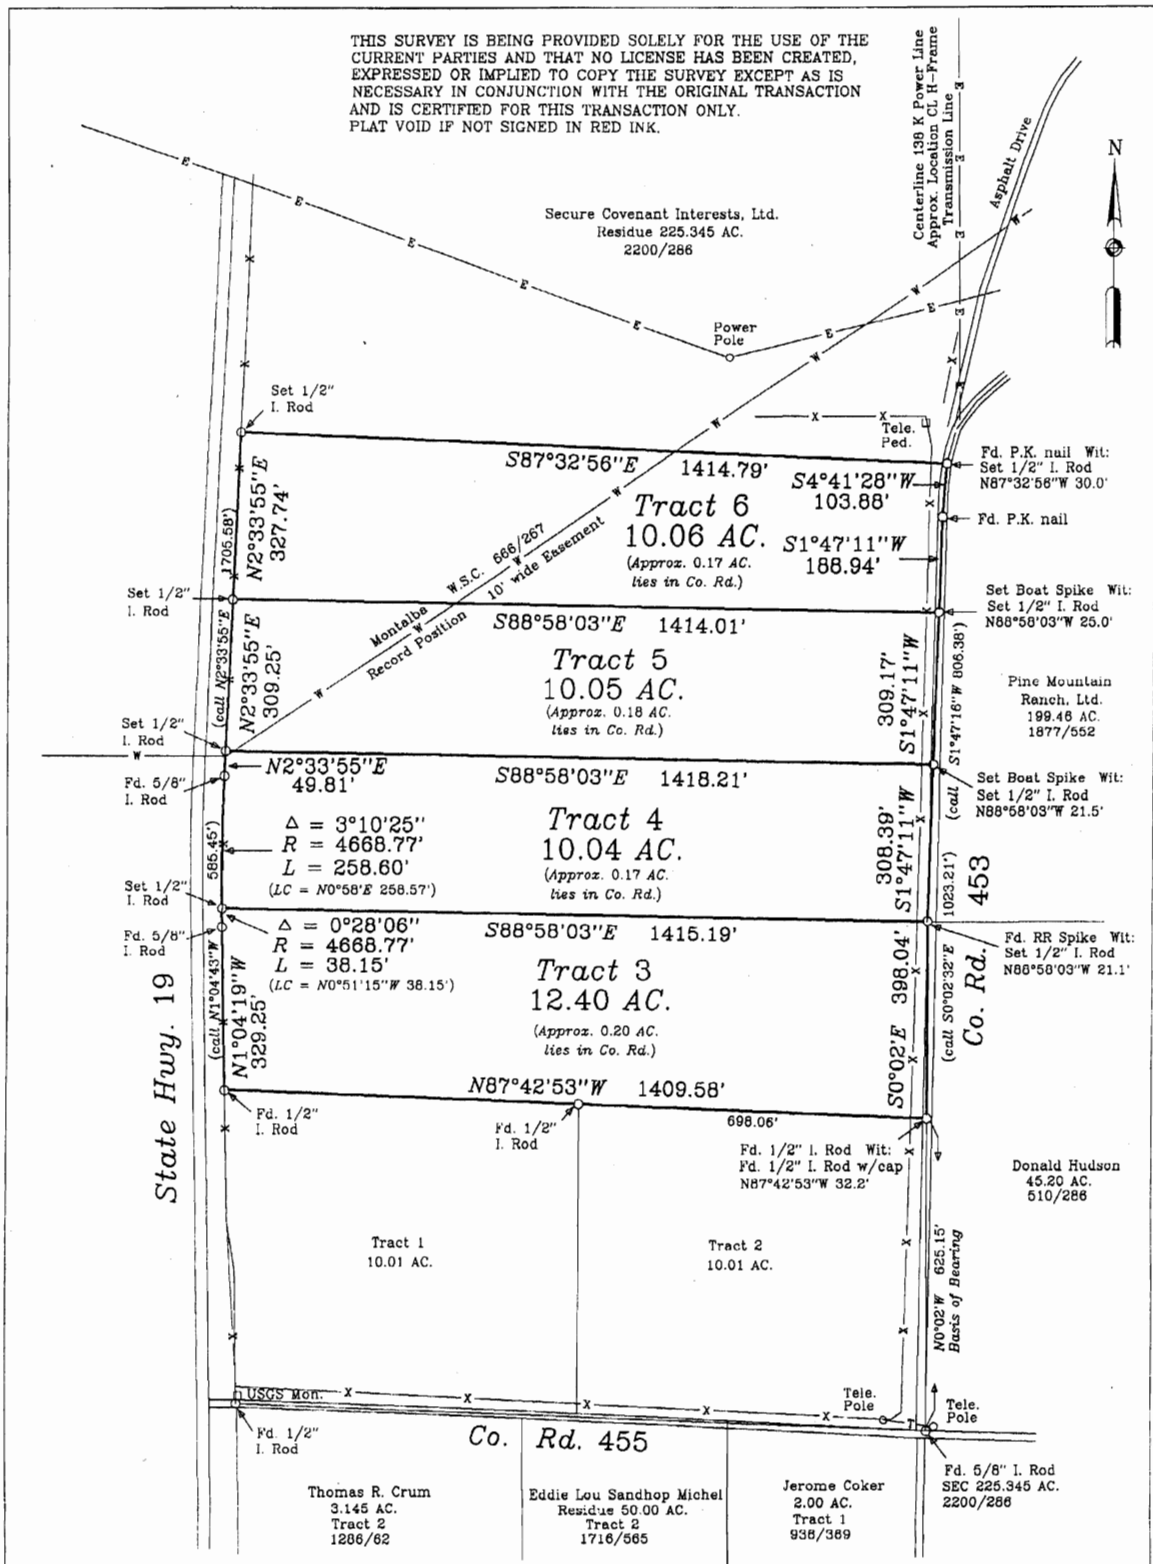

FIELD NOTES ACCOMPANY THIS PLAT

SCALE = 1" = 300'

I, Billy D. Murphree, Jr., R.P.L.S. No. 3962, declare that the plat shown hereon represents the results of an on the ground survey made under my direction and supervision on June 10, 2010 and this survey complies with the Texas Board of Professional Land Surveyors Standards effective September, 1992.

USE OF THIS SURVEY FOR ANY OTHER PURPOSE OR BY OTHER PARTIES SHALL BE AT THEIR OWN RISK AND THE UNDERSIGNED SURVEYOR IS NOT RESPONSIBLE FOR ANY LOSS RESULTING THEREFROM.

BILLY D. MURPHREE, JR., REGISTERED PROFESSIONAL LAND SURVEYOR NO. 3962

SURVEY - GEORGE ANDING LEAGUE A-3

DESCRIPTION - PART 2200/286

COUNTY - ANDERSON

SURVEY FOR - SECURE COVENANT INTERESTS, LTD.

JACK L. WARD & ASSOCIATES
Registered Professional Land Surveyors
P. O. Box 1490, Athens, Texas 75751
Phone (903) 675-3819