

SUBSURFACE SEWAGE DISPOSAL SYSTEM PERMIT DISCLOSURE

1 Regarding: 797 Spring Creek Rd., Dandridge, TN 37725
2 PROPERTY ADDRESS

3 The owner of this residential property discloses the following:

4 ☒ According to the subsurface sewage disposal system permit issued for this property, this property is permitted for 3
5 (number of) bedrooms. A copy of the permit was obtained from the appropriate governmental permitting authority and
6 is attached to this disclosure.

7 ☐ I/We have requested a copy of the subsurface sewage disposal system permit issued for this property from the
8 appropriate governmental permitting authority. However, I/We were informed that

9 ☐ The file could not be located.

10 OR

11 ☐ A permit was not issued for this property. As a result, I/we do not have any knowledge as to the number of
12 bedrooms this property has been permitted.

13 NOTE: There may be additional information which may be of interest and/or concern to Buyers contained in the official file
14 with the Tennessee Department of Environment and Conservation, Groundwater Protection division located in the
15 county office regulating septic systems. This file may contain information concerning maintenance that has been
16 done on the system as well as any violations imposed by the state. Buyers are encouraged to obtain this information
17 and if of concern to them, to have a soil engineer interpret the contents of the file. Real estate licensees are not soil
engineers and are not experts who can provide an interpretation of the contents of the official file.

18 The following parties have reviewed the information above and certify, to the best of their knowledge, that the information
19 they have provided is true and accurate and acknowledge receipt of a copy:

20 The party(ies) below have signed and acknowledge receipt of a copy.

21 BUYER

22 BUYER

23 Date

24 at o'clock ☐ am/ ☐ pm

at

o'clock ☐ am/ ☐ pm

Date

25 The party(ies) below have signed and acknowledge receipt of a copy.

26 SELLER

27 Rick A Walker

28 SELLER

29 Marcia Cole-Walker

10/27/2010 at 11:22 o'clock ☐ am/ ☐ pm

10/27/2010 at 11:22 o'clock ☐ am/ ☐ pm

at

o'clock ☐ am/ ☐ pm

Date

Date

NOTE: This form is provided by TAR to its members for their use in real estate transactions and is to be used as is. By downloading and/or using this form, you agree and covenant not to alter, amend, or edit said form or its contents except as where provided in the blank fields, and agree and acknowledge that any such alteration, amendment or edit of said form is done at your own risk. Use of the TAR logo in conjunction with any form other than standardized forms created by TAR is strictly prohibited. This form is subject to periodic revision and it is the responsibility of the member to use the most recent available form.



Copyright 2010 Tennessee Association of Realtors®

F84 - Subsurface Sewage Disposal System Permit Disclosure, Page 1 of 1

This document was generated using the Instant Forms Document Management Service, www.instantforms.com.

Modified on 1/01/2010

FIRST VISIT ☒
 SUBSEQUENT VISIT ☐
 UNKNOWN ☐

INSTALLATION OR REPAIR RECORD OF SEPTIC TANK SYSTEM

None
 TYPE OF ESTABLISHMENT

OWNER Stokley Paul D. Edwards Jr.
 ADDRESS Spring Creek Rd.
 LOCATION Spring Creek Rd.

OCCUPANT Pro-Crete Crete CIVIL DISTRICT 1

TANK TYPE Pro-Crete Crete

FIELD LINE: LINEAR FEET OF TILE 8 WIDTH OF TRENCH 1' LIQUID CAPACITY (GAL) 900


DEPTH OF TRENCH 1' LENGTH OF TRENCH 124'

SKETCH OF SYSTEM: BY C.R. Blandon DATE 11-13-72 GARBAGE GRINDER PROPOSED: YES () NO ()

JEFFERSON COUNTY HEALTH DEPT.

ENVIRONMENTALIST

C.R. Blandon

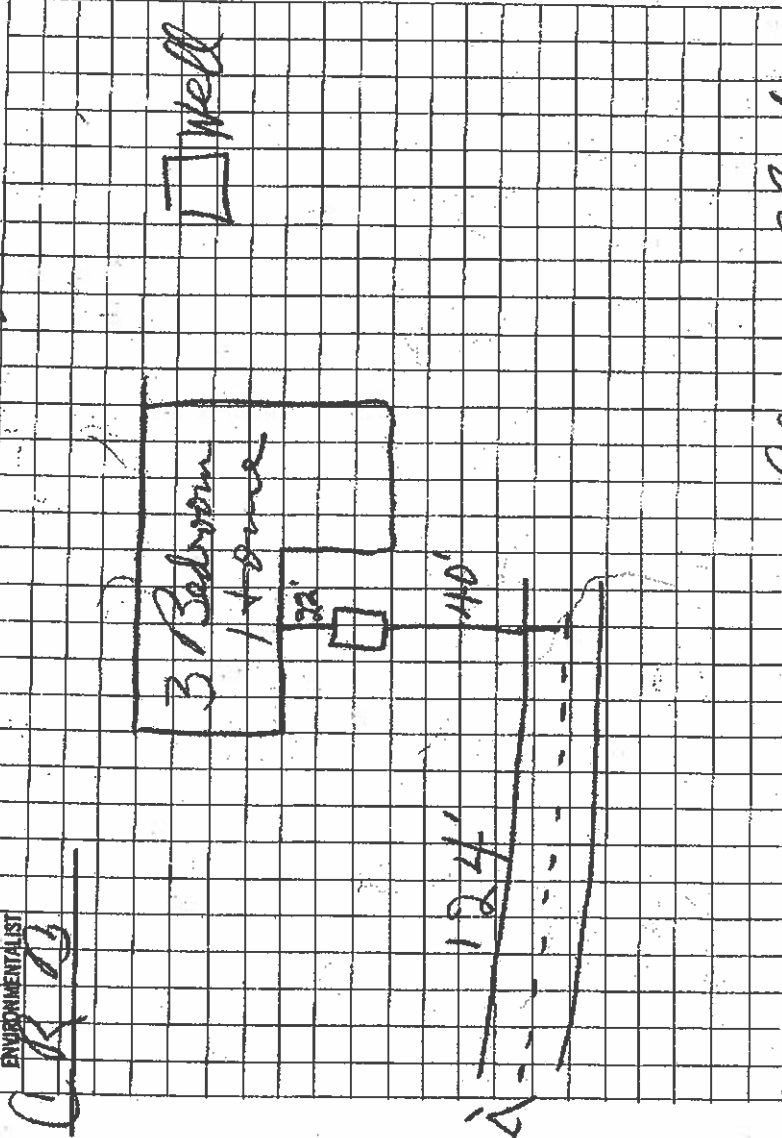

FINAL APPROVAL: YES ☒ NO () DATE 11-15-72

Clifford Blandon
 SIGNATURE

REMARKS:

NOTE: Plumber must notify the _____

Health Department / H