


## FINAL AS-BUILT INSTALLATION

**Address/Legal Description:**  
**Subdivision/Block/Lot:**

17718 E. 57<sup>TH</sup> Ave  
54063.9032

Application #:

00-2220

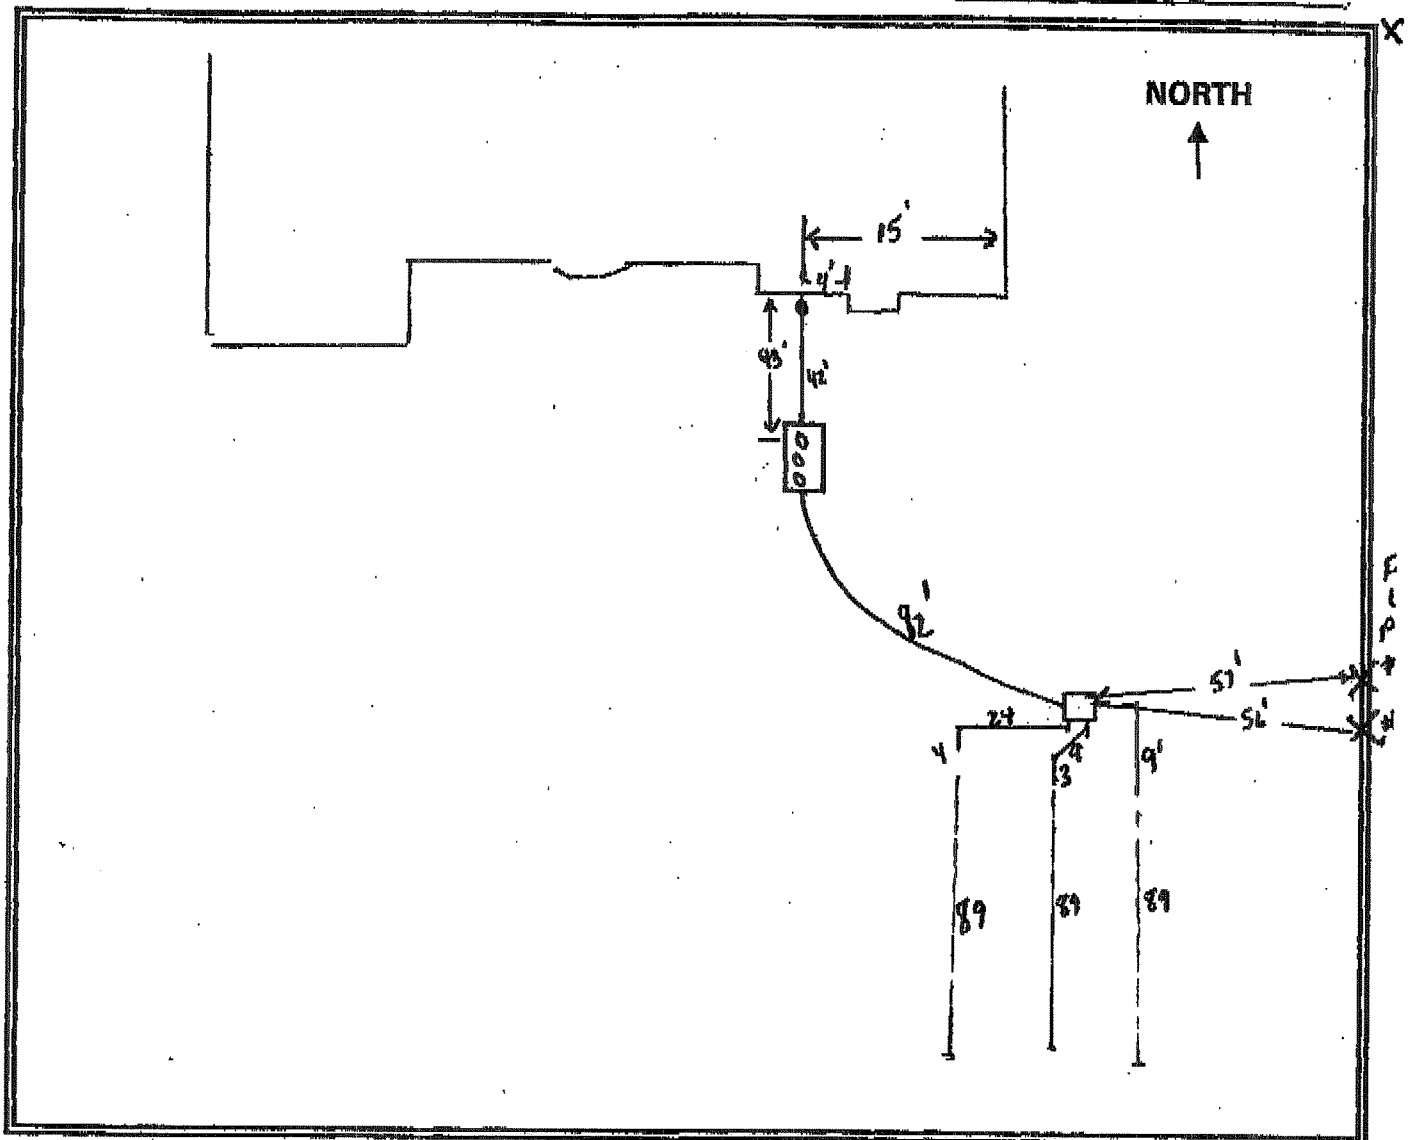

**Note: The location of the on-site sewage system represented by the drawing is not to be construed as an exact location of the system.**

Remarks: Replacement lines to be installed between

regard offset G'

LDI 200088327 8/22/00 Doc 01-303

**Partial Inspection Signature:**

Date:

**Final Inspection Signature:**

Date:

Pump Chamber: 570 gals.  
Septic Tank Size: 1800 gals.  
Drainfield: 267 ft.  
Leachbed: NA sq. ft.  
Density is based on soil type: IV  
Measured drawdown: 12" in.  
Residual head: NA ft.  
Pump run time: NA min.  
Pump off time: NA hr.

**Asbuilt 6/2000**