

Attention Owner:
 Confidentiality Privilege Notice
 on reverse owner's copy.

Kendall Co

Texas Department of License and Regulation
 Water Well Driller/Pump Installer Program
 P.O. Box 12157 Austin, Texas 78711 (512) 463-7880 FAX (512) 463-8616
 Toll free (800) 803-9202
 Email address: water.well@license.state.tx.us

WELL REPORT

This form must be completed and filed with the department and owner within 60 days upon completion of the well.

1) OWNER **A. WELL IDENTIFICATION AND LOCATION DATA**

Name Mike Walters	Address P.O. Box 82	City Waring	State TX	Zip 78074
-----------------------------	-------------------------------	-----------------------	--------------------	---------------------

2) WELL LOCATION

County Kendall	Physical Address Blaske Rd	City Welfare	State TX	Zip 75976
--------------------------	--------------------------------------	------------------------	--------------------	---------------------

3) Type of Work	Lat. 29 55 20N Long. 98 50 33W Grid # 68-02-4
------------------------	--

☒ New Well ☐ Deepening ☐ Reconditioning	4) Proposed Use (check) ☐ Monitor ☐ Environmental Soil Boring ☒ Domestic ☐ Industrial ☐ Irrigation ☐ Injection ☐ Public Supply ☐ De-watering ☐ Testwell If Public Supply well, were plans submitted to the TNRCC? ☐ Yes ☐ No	5) N1
--	---	---------------------

6) Drilling Date Started 6/03/02 Completed 6/12/02	Diameter of Hole <table border="1"> <tr> <th>Dia. (in)</th> <th>From (ft)</th> <th>To (ft)</th> </tr> <tr> <td>8 3/4</td> <td>0</td> <td>10</td> </tr> <tr> <td>7</td> <td>10</td> <td>580</td> </tr> </table>	Dia. (in)	From (ft)	To (ft)	8 3/4	0	10	7	10	580	7) Drilling Method (check) ☐ Driven ☒ Air Rotary ☐ Mud Rotary ☐ Bored ☐ Air Hammer ☐ Cable Tool ☐ Jetted ☐ Other
Dia. (in)	From (ft)	To (ft)									
8 3/4	0	10									
7	10	580									

From (ft)	To (ft)	Description and color of formation material	8) Borehole Completion ☐ Open Hole ☒ Straight Wall ☐ Under-reamed ☐ Gravel Packed ☐ Other
0	10	Calache	
10	40	Tan Limestone	
40	100	Light Green & Brown Limestone (water)	
100	180	Light Green Limestone & Green Shale	
180	200	Light Green & Tan Limestone	
200	260	Light Green Limestone & Green Shale (water)	
260	300	Light Green & Brown Limestone	
300	380	Light Green & Tan Limestone	
380	420	Green Shale & Dark Brown Limestone	
420	480	Green Shale & Green & Brown Limestone w/Red Clay	
480	580	Green & Dark Brown Limestone & Green Shale at end (Water at 500,520,540)	

(Use reverse side of Well Owner's copy, If necessary)


13) Plugged ☐ Well plugged within 48 hours Casing left in well: _____ Cement/Bentonite placed in well: _____ <table border="1"> <tr> <th>From (ft)</th> <th>To (ft)</th> <th>From (ft)</th> <th>To (ft)</th> <th>Sacks used</th> </tr> <tr> <td></td> <td></td> <td></td> <td></td> <td></td> </tr> <tr> <td></td> <td></td> <td></td> <td></td> <td></td> </tr> <tr> <td></td> <td></td> <td></td> <td></td> <td></td> </tr> </table>	From (ft)	To (ft)	From (ft)	To (ft)	Sacks used																9) Cementing Data Cementing from 0 ft. to 2 ft. # of sacks used 1 Grouting from 2 ft. to 460 ft. # of sacks used 17 Method Used Pressure Grouting Cementing By Armadigger Inc. Distance to septic system field or other concentrated contamination _____ ft. Method of verification of above distance _____
From (ft)	To (ft)	From (ft)	To (ft)	Sacks used																	

14) Typepump ☐ Turbine ☐ Jet ☒ Submersible ☐ Cylinder ☐ Other N/A Depth to pump bowls, cylinder, jet, etc., 315 ft.	10) Surface Completion ☒ Specified Surface Slab Installed ☐ Specified Surface Sleeve Installed ☐ Pitless Adapter Used ☐ Approved Alternative Procedure Used
---	---

15) Water Test Type test ☐ Pump ☐ Boiler ☒ Jetted ☐ Estimated Yield: 10 gpm with _____ ft. drawdown after _____ hrs.	11) Water Level Static level 315 ft. below _____ Date 6/12/02 Artesian Flow _____ gpm Date 1/1
---	--

16) Water Quality Did you knowingly penetrate any strata which contain undesirable constituents? ☐ Yes ☒ NO If yes, did you submit a REPORT OF UNDESIRABLE WATER? Type of water: _____ Depth of Strata: _____ Was a chemical analysis made? ☐ Yes ☒ No	12) Packers <table border="1"> <tr> <th>Type</th> <th>Depth</th> </tr> <tr> <td>2 Rubber</td> <td>460 480</td> </tr> </table>	Type	Depth	2 Rubber	460 480
Type	Depth				
2 Rubber	460 480				


Company or Individual's Name (type or print) Armadigger Inc.		License No. 4404 WPKL	
Address P.O. Box 1329		City Bandera	State TX Zip 78003
Signature <i>David Schaback</i> 6/18/02 Licensed Driller/Pump Installer	Signature <i>Alton</i> 6/18/02 Apprentice	Date	

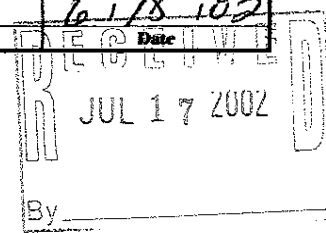

KENDALL COUNTY
 Department of
DEVELOPMENT MANAGEMENT
 201 East San Antonio Street, Suite 100
 Boerne, Texas 78006
 Telephone: (830) 249-9343 Ext. 201

FILE # S 6087**SEPTIC FORM**Private Sewage Facility (Licensed) in Kendall County, Texas**APPLICANT INFORMATION:**Property Owner (Licensee) Mike Walters Contractor home owner self installedSubdivision or Location 18A B. Buschke Rd.Total Area Sq. Ft. _____ or Acres 6.5No. Bedrooms 3 or Sq. Ft. of House 2500 of Gal/Day 240Perc Rate .2 Class No. III Trench Req. Sq. Ft. 1200

or Bed Req. Sq. _____

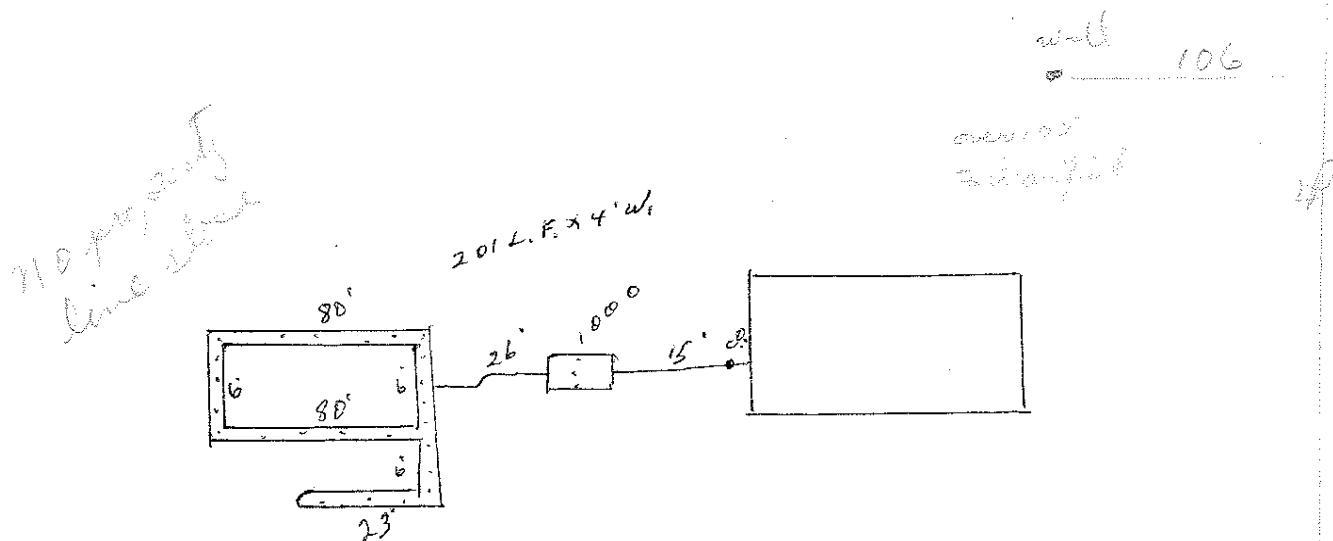Gallon Capacity Req. for Concrete Septic Tank 1000 - 2 CompartmentInstalled: Length 201 Width 4Sq. Ft. 1206 Bed _____ Trench ✓Remarks: _____
 (Sketch of Approximate Distances, Not To Scale.)

The County of Kendall, The Texas Department of Health, or their agents or designees, makes no representation that facilities herein licensed will provide satisfactory service to the premises served. It will be the licensee's responsibility to make any changes or modifications which operating experience may show to be necessary in order for these facilities to provide satisfactory service. Septic distances meet minimum Texas Department of Health separation distances in most instances. Some renovations may be less if repaired or replaced in the same general area as the pre-existing system being renovated.

PERMIT (LICENSE) GRANTED AND APPROVED THIS DATE 6-5-02

Sanford J. Jennings
 Designated Representative