

PERMIT APPROVAL SPECIFICATIONS

Owner information:

Calvin Powell

Name

POB 195

Mailing address

Chesler Heights, PA 19017

City

01-070

Permit Number

-1	19	24
32	24	27
S	T	R

12/24/00
Date submitted

12/8/00
Date Approved

12/8/01
Expiration Date

Permit specifications:

This permit is approved with the following specifications:

1000 gal size of tank

160 lf lineal feet of drainfield

(320 sf square feet of drainfield)

_____ any special design for the system. List design
specifications: System is to be installed exactly as
per lot layout.

J Initials of Sanitarian

form: septic/permit forms/approval form

11-16-01
J

NOV 2 2001

AS-BUILT SKETCH
AND
STATEMENT OF ACCURACY OF INSTALLATION

Land owner's name Cabin Powell

Permit number 01-070

I, Robert C. McCoy as the licensed installer for the following system have either
(Printed Name of Installer)
constructed or altered the septic system or supervised and/or approved the construction of the
septic system of the above noted parcel.

I do hereby declare that the specifications of the approved permit issued have been followed.
Accompanying this statement is a copy of the lot layout to file in the Courthouse Environmental
Health office. This statement and the "as-built" sketch on the back of this page or attached to this
page shall be submitted to the Environmental Health office within ten (10) days of completion of
the system.

Installer's Signature Robert C. McCoy

Installer's License Number LT-HS-01

Completion Date of System 10-24-01

called in 1:15 P.M.
10/22/01
Left msg.


Checklist of as-built:

- ☒ North arrow
- ☒ triangular measurements from house to tank
- ☒ measurement of pipe from tank to D-box or manifold
- ☒ length of drainfield laterals
- ☒ number of drainfield laterals

file reg/as-builts form

by: Robert C. McI. | As Built Drawg. | : Calvin Powell
Irris. Equip. Sales, Inc. Permit # 01-070
Lic. # LI H501

← NORTH

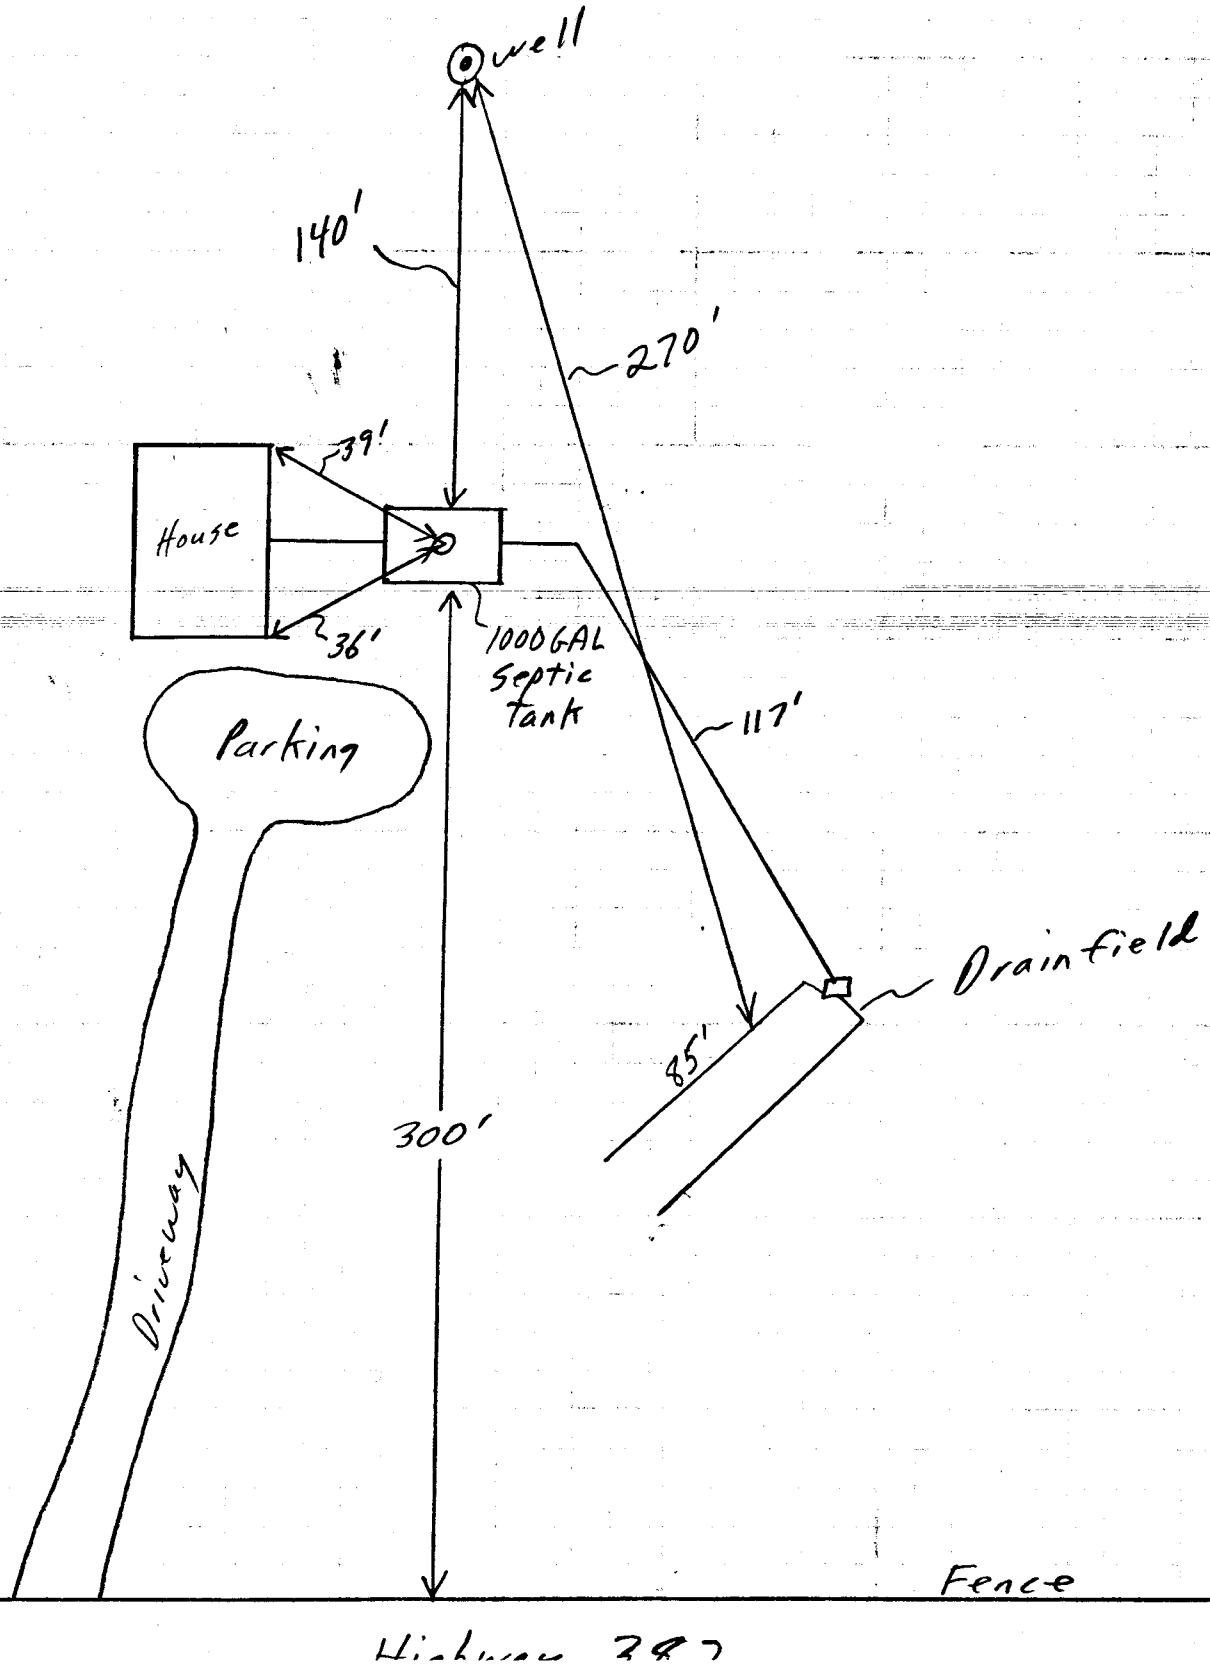

22-141 50 SHEETS
22-142 100 SHEETS
22-144 200 SHEETS

