

TEXAS ASSOCIATION OF REALTORS®

INFORMATION ABOUT ON-SITE SEWER FACILITY

USE OF THIS FORM BY PERSONS WHO ARE NOT MEMBERS OF THE TEXAS ASSOCIATION OF REALTORS® IS NOT AUTHORIZED ©Texas Association of REALTORS®, Inc., 2004

CONCERNING THE PROPERTY AT Glen Rose, TX 76043	
A. DESCRIPTION OF ON-SITE SEWER FACILITY ON PROPERTY:	
(1) Type of Treatment System: Septic Tank 💆 Aerobic Treatment	Unknown
(2) Type of Distribution System: A e voluc	Unknown
(3) Approximate Location of Drain Field or Distribution System:	Unknown
(4) Installer: Goot Coustruction - Growby (Rayclas Scott) (5) Approximate Age: 8405	Unknown
B. MAINTENANCE INFORMATION:	
(1) Is Seller aware of any maintenance contract in effect for the on-site sewer facility? If yes, name of maintenance contractor: Phone: 272 8944 contract expiration date: Maintenance contracts must be in effect to operate aerobic treatment and certain non-sewer facilities.)	47 2 yes
(2) Approximate date any tanks were last pumped? May 2004	
(3) Is Seller aware of any defect or malfunction in the on-site sewer facility? If yes, explain:	Yes No
(4) Does Seller have manufacturer or warranty information available for review? C. PLANNING MATERIALS, PERMITS, AND CONTRACTS:	☐ Yes Ø No
(1) The following items concerning the on-site sewer facility are attached: planning materials permit for original installation final inspection when OS maintenance contract manufacturer information warranty information	SF was installed
(2) "Planning materials" are the supporting materials that describe the on-site sewer submitted to the permitting authority in order to obtain a permit to install the on-site sev	facility that are ver facility.
(3) It may be necessary for a buyer to have the permit to operate an on-site transferred to the buyer.	•
TAR-1407) 1-7-04 Initialed for Identification by Buyer Amala and Seller	Page 1 of 2

Century 21 Quad J Realty 1305 Nf: Big Bend Trail Glen Rose, TX 76043 Phone. (254) 897 - 7005 25 Fax: (254) 897 - 3375 Deedee Jones


D. INFORMATION FROM GOVERNMENTAL AGENCIES: Pamphlets describing on-site sewer facilities are available from the Texas Agricultural Extension Service. Information in the following table was obtained from Texas Commission on Environmental Quality (TCEQ) on 10/24/2002. The table estimates daily wastewater usage rates. Actual water usage data or other methods for calculating may be used if accurate and acceptable to TCEQ.


Facility	Usage (gal/day) without water- saving devices	Usage (gal/day) with water- saving devices
1 don'ty	Saving devices	saving devices
Single family dwelling (1-2 bedrooms; less than 1,500 sf)	225	180
Single family dwelling (3 bedrooms; less than 2,500 sf)	300	240
Single family dwelling (4 bedrooms; less than 3,500 sf)	375	300
Single family dwelling (5 bedrooms; less than 4,500 sf)	450	360
Single family dwelling (6 bedrooms; less than 5,500 sf)	525	420
Mobile home, condo, or townhouse (1-2 bedroom)	225	180
Mobile home, condo, or townhouse (each add'l bedroom)	75	60

This document is not a substitute for any inspections or warranties. This document was completed to the best of Seller's knowledge and belief on the date signed. Seller and real estate agents are not experts about on-site sewer facilities. Buyer is encouraged to have the on-site sewer facility inspected by an inspector of Buyer's choice.

Affiliad year	03/05/2008	illi o m	03/05/2008
Signature of Seller C. Edward Yager II	Date	Signature of Seller Gail Yager	Date
Receipt acknowledged by:			
Signature of Buyer	Date	Signature of Buyer	Date

Sewer Septic System

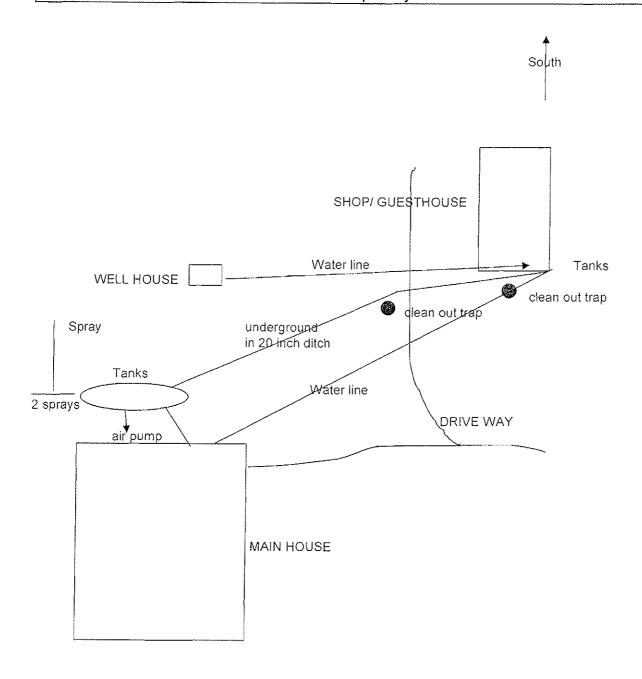

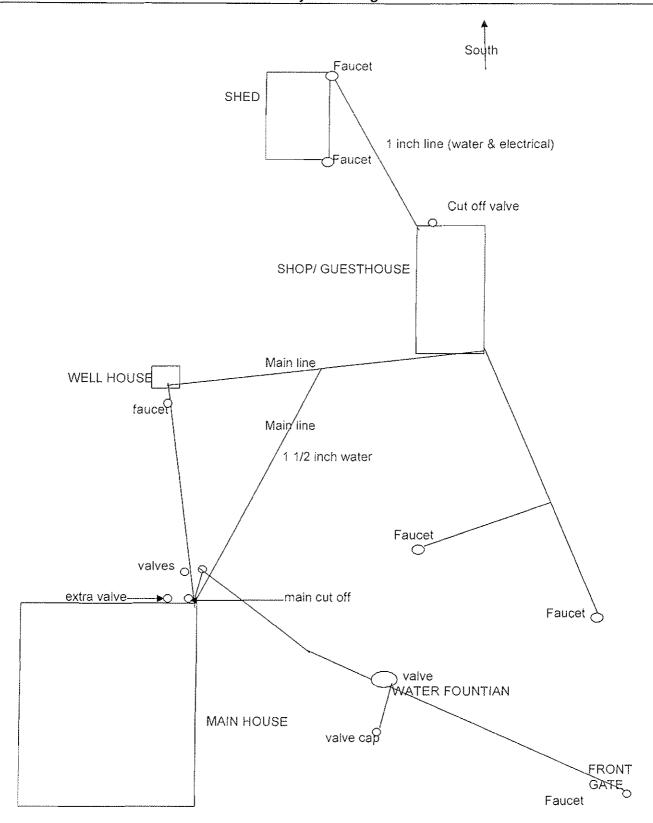

Boad