



10/27/03 12:43 PM

Williamson County and Cities Health District NOTICE OF APPROVAL TO OPERATE AN OSSF

THIS IS TO CERTIFY that the on site sewage facility located at:

OSSF #: **2003 - 3367**125 CR 231, Florence TX 76527

Grid:

JAMES MILLER SURVEY ABST. NO. 414Block: Lot: ☐ Routine Maint

meets or exceeds the basic requirements established by the District.

LICENSE TO OPERATE this facility is hereby granted to the owner. This license simply grants permission to operate this facility; it does not guarantee its successful operation. Routine maintenance and proper functioning are the sole responsibility of the owner. KEEP THIS LICENSE with important papers. You may need it when selling your house or if a malfunction occurs.


THIS LICENSE REMAINS in effect until such time as there is evidence that this facility is not operating properly and may constitute a threat to the health of the people of Williamson County.

Tank Type: Concrete BoxValve: K RainMax Flow: 240 gal/dayTank Size: 1000 gallonsDrainfield Size: 1200 sq. ft.

Installed By:

Engineered By: HANK PETERS, R.S.

DRAWING OF SYSTEM (Not to scale):

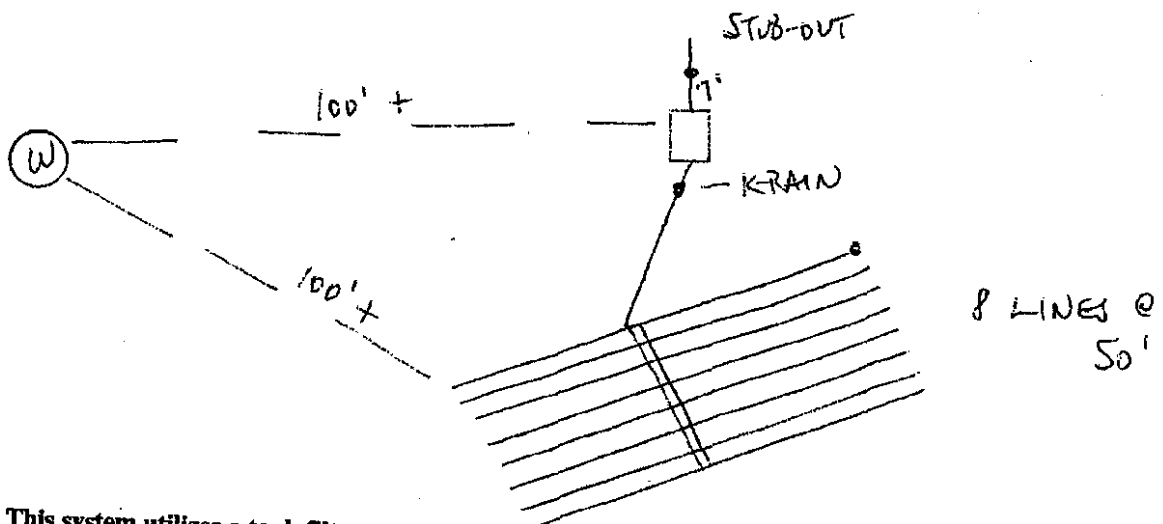

This system utilizes a tank filter.
To prevent backups clean filter regularly.

DATE OF FINAL
INSPECTION:

10/24/03

ISSUED THIS DATE:

10/27/03


Annika Andrews #9229

INSPECTOR

[Signature]**OS 7173**

DIRECTOR, ENVIRONMENTAL SERVICE

R-10

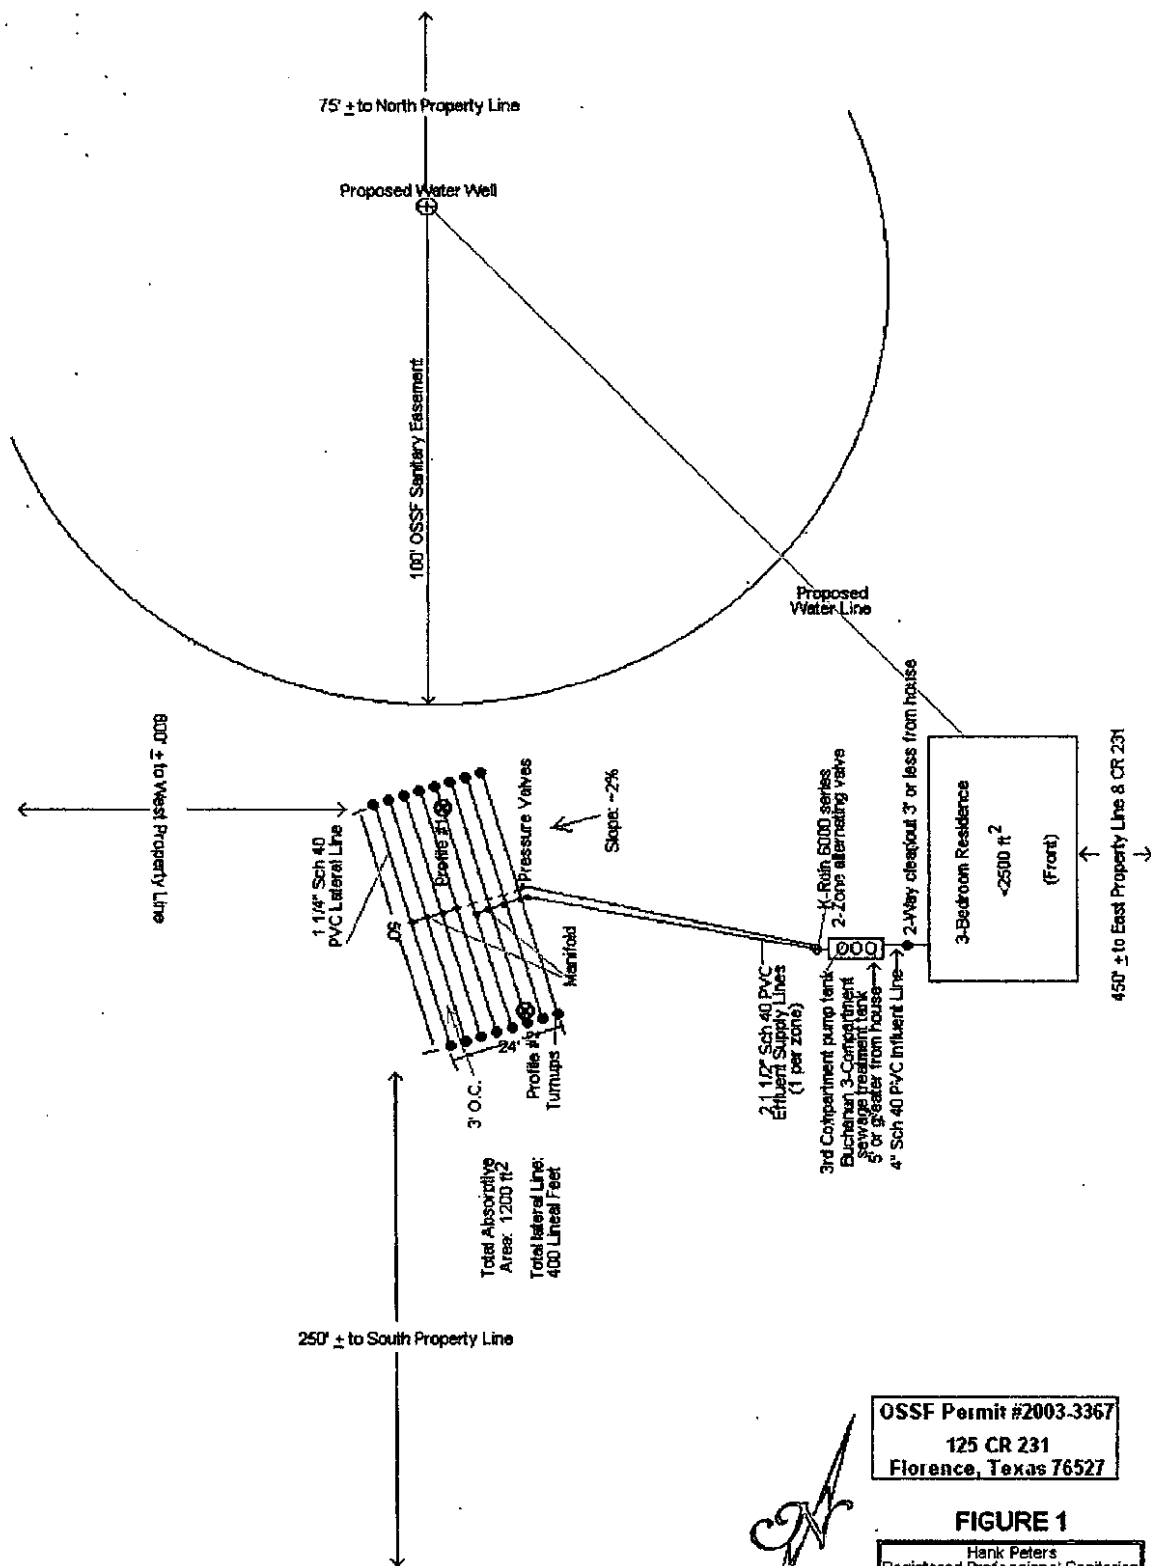

OSSF Permit #2003-3367
125 CR 231
Florence, Texas 76527

FIGURE 1

Hank Peters
Registered Professional Sanitarian
P.O. Box 1221
Georgetown, Texas 78627
512/763-1656

Scale: 1" = 30'