

**WV STATE DEPARTMENT OF HEALTH**  
Office of Environmental Health Services  
**ENVIRONMENTAL ENGINEERING DIVISION**

**WELL COMPLETION REPORT**

Date(s) 7/13/-7/14/01 County Hampshire Permit #: DW-14-01-246  
 Town: Capon Bridge Area Name/Location Teahenny Estates Lot 4  
 Well Owner: Mike McIntire Address: P. O. BOX 2302  
Winchester, VA 22604  
 Telephone Number: 540-858-2634  
 Well Driller: Donald R. Michael Address: 165 Lindey Lane  
Berryville, VA 22611  
 Telephone Number: 540-955-3582

**WELL LOG**

DEPTH IN FEET	FORMATIONS: KIND, THICKNESS, AND IF WATER BEARING	REMARKS:
0' to 20'	overburden	Type of Well: <u>domestic</u> Drilling Method: <u>air rotary</u>
20' to 220'	shale	Well Diameter: <u>6"</u> Casing O.D.: <u>6 5/8"</u>
		Well Depth: <u>220'</u> Date Completed: <u>7/14/01</u>
205'	waterbearing	CASING: Length <u>40</u> Feet Height above ground <u>1</u> Feet
		<input checked="" type="checkbox"/> Steel <input type="checkbox"/> Plastic <input type="checkbox"/> Cast Iron
		Other _____ Type _____
		<b>SCREEN</b>
		<input checked="" type="checkbox"/> None Installed
		Type _____ Diameter _____
		Slot/Gauge _____ Length _____
		Set Between _____ Ft. and _____ Ft.

**PUMPING OR BAILING TEST**

DETAILS	#1	#2	#3
Static Water Level (Ft. Below Grade)	50		
Pumping Rate (GPM)	15		
Pumping Level (Ft Below Grade)			
Duration of Test (In Hours)	3		
Recovery Time to Static Level (In Hours)			

**WELL HEAD**

Pitless Adapter: Type, Make, Etc. \_\_\_\_\_  
 Well Cap: Type, Make, Etc. Watertight (trega)  
 Well Seal: Type, Make, Etc. \_\_\_\_\_  
 Well Platform: \_\_\_\_\_  
 Length \_\_\_\_\_ Width \_\_\_\_\_ Thickness \_\_\_\_\_  
 Grouting: ☒ Yes ☐ No  
 All Public Water Supplies must be grouted.

I hereby certify that this well was drilled and constructed under my supervision, in compliance with all requirements of the referenced permit, and that this record is true to the best of my knowledge and belief.

Donald R. Michael 505  
 Name Certification No.  
Singhas & Michael Corp.  
 Registered Business Name  
DR Michael 7/16/01  
 Signed Date

INSPECTION TO BE  
PRINTED OR TYPED

## HEALTH DEPARTMENT

Permit No.: 51-1-1-1-1

Tax Map: Parcel #: 51-1-1-1-1

County Road: 51-1-1-1-1

County: WindsorON-SITE SEWAGE DISPOSAL SYSTEM  
INSPECTION FORM

Name of Owner: Lucy & Melanie Oates & Vernis Mullen Installer: G CARPENTER  
 Address: 989 Walltown Rd Winchester VA 22603  
 Property Location: 2.5 Acres Lot Size: 4.16 Sq. Ft./Acres  
 Type of Facility: House Facility is: New ( ) Existing ( )  
 Design Loading in gpd/No. Bedrooms: 3BR Source of Water Supply: Well

## SEWAGE TANK COMPONENT

Capacity in Gallons: 1000 Material: Concrete Manufacturer: UOL  
 Distances (in feet) of Tank to: Dwelling: 30 Private ( )/Public ( ) Water Source: 95' Property Line: 10'

## ON-SITE DISPOSAL SYSTEM

Class I Systems: Standard Soil Absorption Trenches ( ) or Bed ( ) Gravelless Pipe (X), Diameter: 10 Inches  
 Chamber Soil Absorption Trenches ( ) or Bed ( )  
 Class II Systems: Pumped/Dosed Soil Absorption Trenches ( ) or Bed ( ) Evapotranspiration Trenches ( ) or Bed ( )  
 Shallow Soil Absorption Trenches ( ) or Bed ( ) Other: \_\_\_\_\_

No. of Lines: 3 Length (in feet) of Each: 100, 100, 100  
 Width of Trenches: 24 inches/feet Depth to Bottom of Field: 36 inches  
 If Bed, Dimensions (in Feet): \_\_\_\_\_ If Chamber System, Name: \_\_\_\_\_, No. of Units: \_\_\_\_\_  
 Approved and Adequate Materials Used? Yes (X) No ( ) Size Equates to: 900 Square Feet of Standard Gravel Field  
 Distances (in feet) of System to: Dwelling: 50 Private (X)/Public ( ) Water Source: 112' Property Line: 10'  
 Remarks: \_\_\_\_\_


An inspection indicates that the sewage disposal system described above

DOES MEET (X)  
 DOES NOT MEET ( ),  
 CANNOT BE DETERMINED TO MEET ( ) the minimum standards established by the West Virginia Bureau of Public Health.

To correct a health hazard, modifications to existing systems may be done to improve part of a system. Such modifications may not be able to be designated as a does meet system since inadequate information is known.

Although many factors contribute to the successful functioning of a sewage disposal system, this office recommends water conservation and maintaining an even usage of water throughout the week.

Sketch of Installation with Triangulation or Distance to Specific Landmarks:

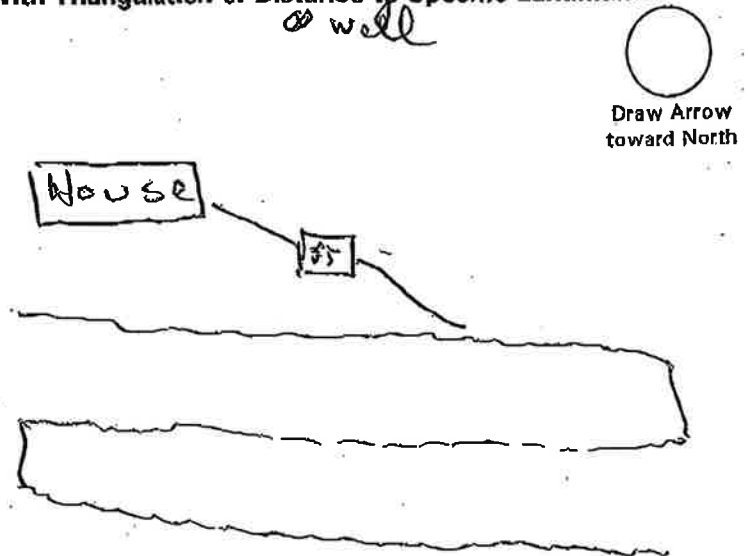

Not to Scale

Visit Date(s): 8-15-01Final Inspection Date: 9-5-01Sanitarian: J. K. Kuntz