
PARTITION PLAT No. 1999-P-164 S 1/2 Section 22, T.28S. R.14E., W.M. Lake County, Oregon



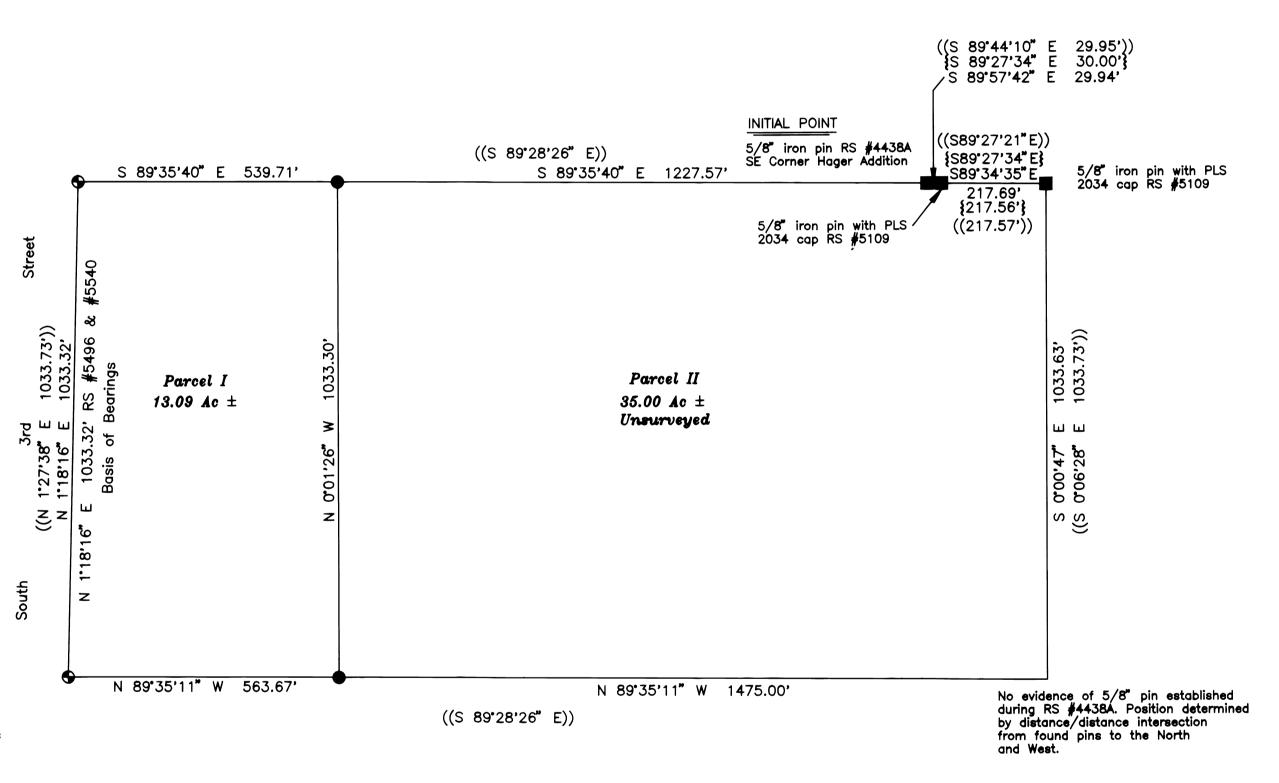

- Set 5/8" x 30" iron pin with yellow plastic
- RLS 1664 cap

 Found 5/8" iron pin with RLS 1664 cap
 as per RS #5496
- Found monument as noted
- Record as per RS #5109
- (()) Record as per RS #5476 [] Record as per RS #4438A

Narrative

Purpose: To survey and monument the boundaries

Procedure: Monuments were found and accepted as shown and Parcel I was laid out as per the owners request.

I herby certify that this map is an exact tracing of the original.

last 6. Sundet

Surveyors Certificate

I, Carl E. Sundet, a Registered Professional Land Surveyor in the State of Oregon, hereby certify that I have correctly surveyed and marked with proper monuments as provided by

surveyed and marked with proper monuments as provided by law Parcel I. Parcel II is shown to satisfy the requirements of ORS Chapter 92. The original parcel is described as:

T.28S. R.14E., W.M., Lake County, Oregon.

Section 22: That part of the SE1/4 SW1/4 and W1/2 SW1/4 lying outside of the Town of Silver Lake described as:

Beginning at a 5/8" iron pin that marks the SE Corner of the Hager Addition to Silver Lake, thence S89.57.42" E a distance of 29.94 feet, thence S89.34.35" E a distance of 217.69 feet, thence S89.34.35" E a distance of 217.69 feet, thence S0'00'47" E a distance of 1033.63 feet, thence N89°35'11"W a distance of 2038.67 feet, thence N1°18'16"E a distance of 1033.32 feet, thence S89°35'40"E a distance of 1767.28 feet to the point of beginning.

> PROFESSIONAL LAND SURVEYOR DREGON JULY 14, 1978 CARL E. SUNDET

See Partition Plat Consent Affidavit and Declaration filed in Deed Volume 244 at Page 779 Lake County Records.

Lake County Clerk

Planning Director

I hereby certify that all ad valorem taxes and all fees or charges as Per ORS 92.095 have been paid.

Lake County Assessor & Tax Collector

State Of Oregon County of Lake SS

I hereby certify that the attached Partition Plat was received for record this 19 day of Chianst 1999 at 8:45 O'clock H.M. and filed as Partition Plat No. 1999-P-164 Lake County Records.

__, Lake County Clerk

SURVEY FOR: SURVEY BY:

TOM & KARMEN O'LEARY SUNDET & ASSOCIATES 424 NORTH 1ST STREET P.O. BOX 1228 LAKEVIEW, OREGON 97630 (541) 947-3293

DATE:

APRIL 1999 Drawing #1023

R.S. 5602