

Hampshire County Health Department Installation Permit No. ST-14-79-143

Name of Owner FOSTER, JAMES + JANET  
Address RT. 1, BOX 65, MIDDLETOWN, VIRGINIA 22645  
Property Address DEER HAVEN SUB-DIV. LOT NO. 4, 2 MI. NORTH ON SPRING GAP MT. RD. LEFT 1/2 MILE.

Type Facility Served NEW HOUSE No. Water Closets 2

Lot Size 18 ACRES sq. ft. Area suitable for sewage disposal installation 15,000 sq.ft.

Source of Water Supply DRILLED WELL No. Lavatories 2

No. Bedrooms 3 No. Showers or Tubs 2 No. Baths 2

No. Garbage Grinders 0 No. Automatic Washers 1

Material CONCRETE Length          x Width          x Depth          =          cubic feet

Liquid Depth                      ft. Liquid Capacity 1,000 gal.

Distance to: Dwelling 20' Water Supply 120' Nearest Property Line 60'

Type Drain Line Material PLASTIC Trench Width 36 Inches  
Trench Depth 30 Inches Total Absorption area in Trench Bottom 420 sq. ft.  
Diameter of Drain Line 4 Inches Type Filter Media GRAVEL  
No. of Drain Lines 3 Depth Filter Media Under Drain Line 6 Inches  
Length of Each Line 70', 70', 70' ft. Depth Filter Media Over Drain Line 2 in  
Distance of Disposal Field to: (a) Dwelling 50'  
(b) Water Supply 150' (c) Nearest Property Line 20'

An inspection of the septic tank system described herein disclosed that said system (MEETS, ~~MEETS~~) the minimum standards established by the West Virginia State Department of Health.



SEP. 19, 1979  
Date

Sanitarian

SKETCH OF SYSTEM TO BE DRAWN ON BACK

Note: Copy of this inspection report must be given to owner and the original filed in the Health Department files. PERMANENT RECORD - DO NOT DESTROY.



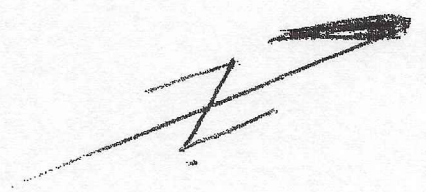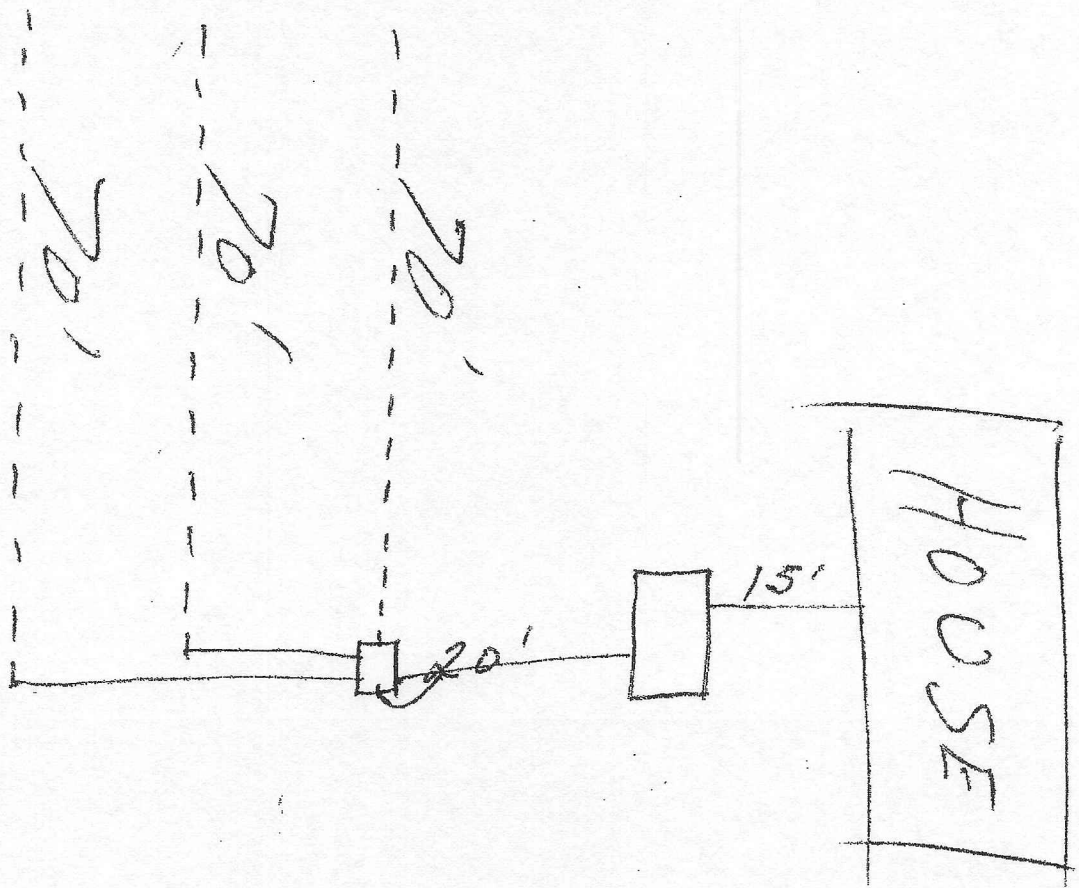

WELL