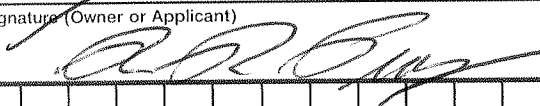
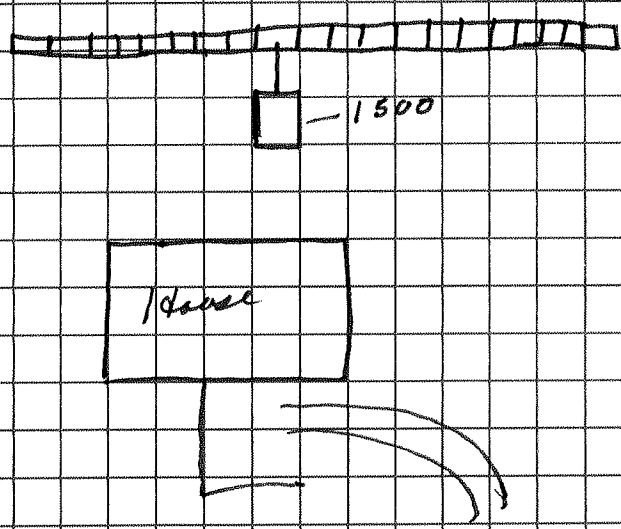
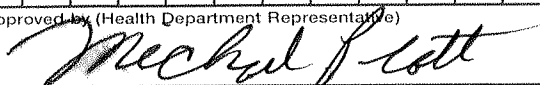


Union County Health Department 55 Hughes St., Suite A, Blairsville, GA 30512		BUILDING PERMIT NO. 347
APPLICATION FOR CONSTRUCTION PERMIT AND SITE APPROVAL FOR ON-SITE SEWAGE MANAGEMENT SYSTEM		RECEIPT NUMBER 7994
PERMIT NUMBER 09716		
(DATES) 8-10-99		
MAILED ☒ GIVEN ☐		
Subdivision, Street or Road 3925 Southern Ridge		
Property Location (Address, Block, Lot, Directions to Property) Southern mill lot #43		
Property Owner's Name R. Proffitt		Date 9-1-98
Owner's Address 1648 Ridge Rd. Blairsville		Phone No. 745-0672
Permit Applicant's Name and Address		Phone No.
Type Facility (Residence, Church, Motel, Restaurant, etc.) ☒ Residence	Water Supply ☒ Public ☐ Community ☐ Individual	Garbage Disposal ☒ Yes ☐ No
		No. of Bedrooms or No. of Gallons Per Day 3
Lot Size 1.057	Soil Conditions (Absorption Field) Percolation Rate 3.5 Min/In; Water Table or Rock Depth _____ Feet; Soil Type evord	
Total Capacity Septic Tank 1000 Gals. Dosing Tank _____ Gals. Grease Trap _____ Gals.	Absorption Field Area Total Sq. Ft. _____ Total Linear Ft. 21 joints Trench Width In. _____ Trench Depth In. _____	Type System Level of Plumbing Outlet ☐ Ground Level ☐ Split Level ☐ Basement Field Layout Method ☐ Distribution Box ☐ Mound ☐ Level Field ☐ Serial Distribution ☐ Other (Explain below)
I hereby apply for a construction permit to install an on-site sewage management system and agree that the system will be installed to conform to the requirements of the rules of the Georgia Department of Human Resources, Chapter 290-5-25. I understand that final inspection is required and will notify the County Health Department upon completion of construction and before applying final cover. A permit is hereby granted to install or construct the on-site sewage management system described above. This permit is not valid unless properly signed below, and expires twelve (12) months from date of issue. Issuance of a construction permit for an on-site sewage management system, and subsequent approval of same by representatives of the Georgia Department of Human Resources or County Board of Health shall not be construed as a guarantee that such systems will function satisfactorily for a given period of time, furthermore, said representatives do not by any action in effecting compliance with these rules, assume any liability for damages which are caused, or which may be caused, by the malfunction of such system.		
Signature (Owner or Applicant) 		Remarks
		
Approved by (Health Department Representative) 	Date of Issue 1-14-99	Date Inspected 8-5-99
Proposed Layout ☒ Final Inspection		Approved ☒ Yes ☐ No