

MAR

92

1
3
1
7

2nd Ave KB

F

12-03
New



BSA

12/03/90

021784

1317 202nd Ave KP

Final in lieu 4/14/92

ASER 12/14/92

Copy 12/23/92 DB
by 3/29/93 LR

Address of Property 1317 202nd AV E KPS

Tacoma-Pierce County Health Department
Environmental Health Division
AS-BUILT SEWAGE DISPOSAL PLAN
(Submit in Triplicate)

#2490

Parcel Number	<u>00-20-04-8-015</u>	Permit Number	<u>21524</u>
Owner	<u>FLOYD SMITH</u>	Address	<u>17728 CHESTNUT ST HESPERIA 92345</u>
Builder	<u>"</u>	Phone	<u>948-1963</u>
Designer	<u>SANDY SMITH</u>	Address	<u>PO BOX 1444 GIG HARBOR WA 98335</u>
Installer	<u>CHARBONNEAU CONSTRUCTION</u>	Phone	<u>851-2178</u>
		Address	<u>11612 SR HY 302 NW GIG HARBOR 98349</u>
		Phone	<u>857-5125</u>

I hereby certify that the accompanying drawing is an accurate representation of the system installed at the listed address. I further certify all recommendations and restrictions (concerning plumbing stub elevations, maintenance of grades, fills surface drains, etc.) listed by me on my approved site plan (or latest approved revision thereof) dated 3/23/93 have been complied with. I further certify that this system meets all requirements of the Tacoma-Pierce County Board of Health Resolution 87-900 and WAC 248-96.

348

Certificate Number

Sandra L. Smith
Signature of Designer

12-14-92
Date

- TO BE FILLED IN BY HEALTH DEPARTMENT ONLY -

Date Accepted 3/23/93 Date Not Accepted 12-12-92 Signature of Sanitarian [Signature]
Remarks IDENTIFY ADJACENT STREETS, IDENTIFY 30 NIPA

Finalized 4/8/92 by TPCHD

INSTRUCTIONS: ATTACH A SEPARATE SHEET WITH AS-BUILT DRAWING. Use a scale which will permit the greatest detail and still contain the entire site on one page.

- ATTENTION HOMEOWNER -

Your septic tank has limitations! It was designed and installed to care for an average-size family. Overloading the septic tank or disturbance of the drainfield may seriously impair satisfactory operation. Points to remember:

1. Have your tank checked periodically to see if pumping is necessary (2 1/2 - 3 years).
2. Do not channel groundwater, surface water, footing drains or downspouts into the tank or drainfield.
3. Do not excavate, fill, place a structure, driveway or patio in, on, or over the drainfield.
4. Limit toilet fixture discharge to normal waste and toilet tissue.
5. Detergents and bleaches used in normal household quantities will not harm the action of the septic tank and drainfield.

MEA 060 11/88

RECEIVED
DEC 14 1992

TACOMA-PIERCE CO. HEALTH DEPT.
ENVIRONMENTAL HEALTH DIVISION

AS-BUILT

FOR: FLOYD & SHERI SMITH
1317 202nd AVE. KPS


JOB# 2490

Peninsula Septic Designs
P.O. Box 1444
Olig Harbor, WA 98216



• 250 LF TOTAL
DRAINLINE
INSTALLED

329.69' N 01°11'54"E
15' N. B. A.

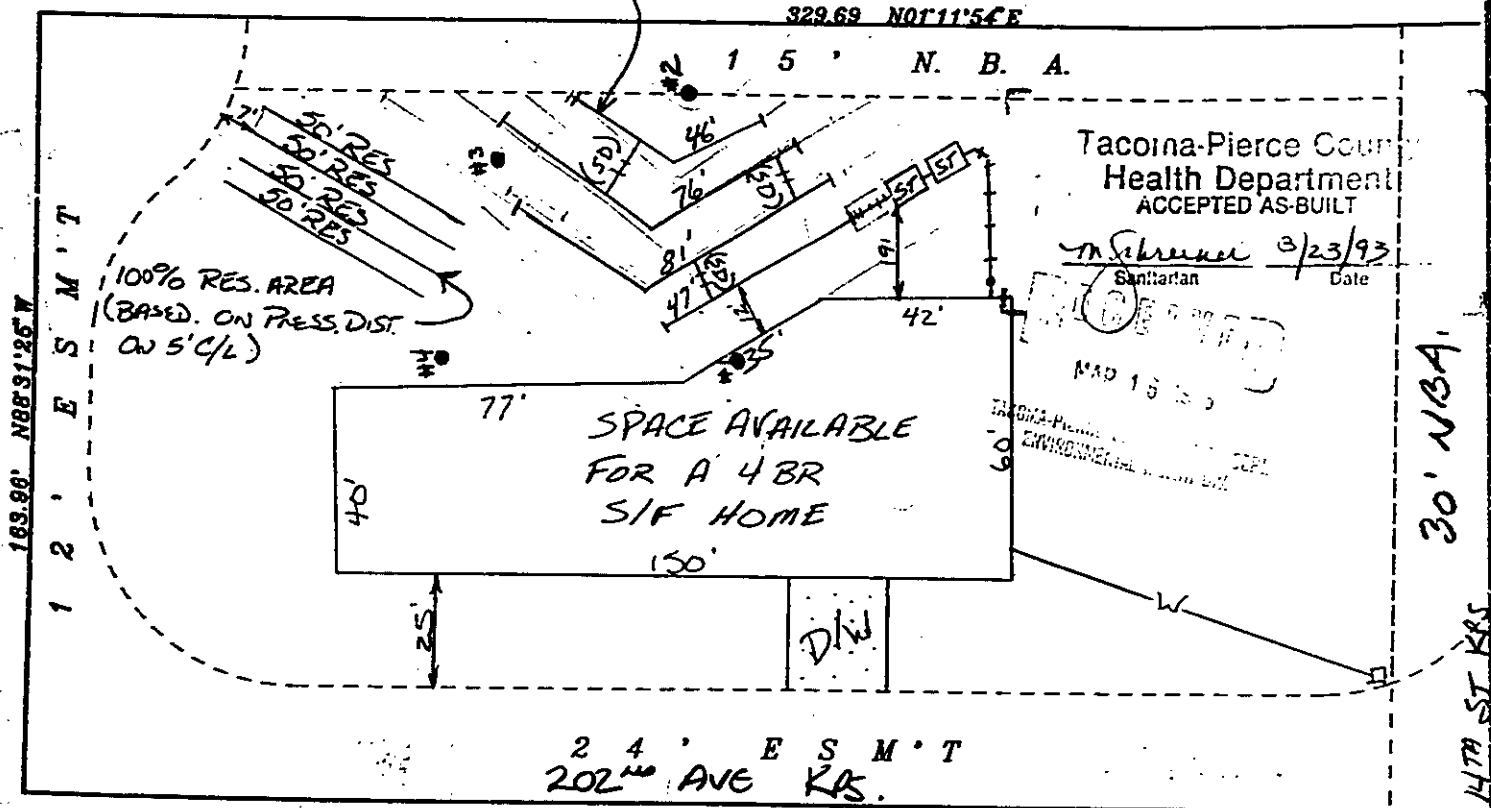

Tacoma-Pierce County
Health Department
ACCEPTED AS-BUILT

M. Schmitt 3/23/93
Sanitarian Date

THE PIA-PENINSULA
ENVIRONMENTAL HEALTH DIV.

SEWAGE SYSTEM PERMIT
TACOMA-PIERCE COUNTY HEALTH DEPARTMENT
 3629 • South "D" Street, EHD 009, Tacoma, WA 98408 (591-6470)

Tacoma-Pierce County
 Health Department

Permit # 21524
 Install _____ Repair _____
 Commercial _____ Residential _____

VALIDATION 3/1/92

RECEIVED

Expires one year from Validation date
DEC 14 1992

INSTALLER Charbonneau Const
 LOCATION 1317 22nd St KPS

OWNER Smith
 All work must be performed in accordance with current laws, ordinances, resolutions, and rules and regulations.

DESIGNER/APPLICANT S. Smith
DO NOT COVER SYSTEM PRIOR TO APPROVAL

Date Accepted <u>4-3-92</u> Disapproved _____	O.K. to Cover <u>ENVIRONMENTAL HEALTH DEPT. APPROVED</u>
Designer <u>Radial Smith</u> Date <u>4-3-92</u>	Sanitarian _____ Date _____
O.K. to cover 3 working days after accepted date unless otherwise indicated by the Sanitarian.	

I have complied with all restrictions and requirements as listed and designed by the Certified Sewage Disposal System Designer as indicated on the approved plan (or latest revision thereof), and have complied with the Tacoma-Pierce County Codes on Sewage Disposal System Installation.

INSTALLER Steve Henderson DATE 3-20-92

TO BE POSTED ON SITE — DO NOT ALTER OR DEFACE

EA-1034

FINAL INSPECTION

DISTRICT _____ E (W) C

DATE: 4-6-92

SITE: 1317 - 202nd St KPS

ADDRESS: _____

Sub/Lot#: _____

APPLICANT: Smith

CALLED IN: Jacky Smith

DESIGNER: " "

INSTALLER: Charbonneau

COMMENTS: _____

☐ Final OK, Hold for Asbuilt

☒ Accept Asbuilt in lieu of Final

☐ Red-Tagged

Date: 4-8-92 Initials: JS

DESIGN

ON-SITE SYSTEM DESIGN APPLICATION

NEW ☒ RENEWAL ☐ REDESIGN ☐

Site Address: 1317 202nd AVE. RBS

Designer ID# 348
(if applicable)

Previous Address:

Applicant Name: SMITH, FLOYD SHERI
Last First # 2490

Applicant Phone No. (619) 948-1963

RECEIVED
DEC 0 - 1990

TACOMA PIERCE CO HEALTH DEPT.
ENVIRONMENTAL HEALTH DIVISION

Health-Environment Health
For Deposit Only:

TPCHD Tacoma Wash
2131 210.00 TOTAL
11 2131 210.00 CHECK
000001 12-03-90 T17108

Applicant Address: 17728 CHESTNUT ST. City: HESTERIA St: CA Zip: 92345
Section: 04 Township: 20 Range: 1W Field Area: TOYCE Parcel: 00-20-04-B-015
Subdivision Name or Plat Recording #: 8501070400 Lot: 3 Block:
Water Supply: P (UPI)-Individual P-Public (More than One Connection) Public Water Supply Name: PWS RD ID: 35362W
Property Size: 53,956 SQ. FT.

Parcel is () or is not (X) within 300 feet of a public sewer, or within ULID sewer service area, or sewer district.

Shellfish Sensitive Area: N (Y/N) If yes, specify area:
Type of Building: SF (SF/MF/COMM/FE/INST)

Any Lot Restrictions: Y (Y/N)

If Yes, specify here briefly and show on design.

SF-Single Family MF-Multi Family COMM-Commercial FE-Food Establishment INST-Institutional

Garbage Disposal Proposed: M (Y/N) Proposed Number of Bedrooms: 4

ROAD ESMTS & NRB
AS SHOWN ON DESIGN

If this is a Community System, address which system is located at: Community System Name & Address:
FOR RENEWAL APPLICATIONS ONLY: Renewal Letter Attached? (Y/N) Copies of original approved design & application attached?
FOR REDESIGN APPLICATIONS ONLY: What has been changed?
SOIL LOGS ATTACHED? Y (Y/N)

Date Soils Logged: 11-20-90 Highest Water Table or Indicators: NONE

CALCULATIONS: Gallons/Day: 600 Application Rate: .80 Absorption Area: 750 Total Length: 250 ft
Tank Size: 1500 gal Maximum Trench Depth: 30"

Designer's Name (printed): SHERI R. SMITH Designer's Signature: SHERI R. SMITH Phone #: 851-2178

Date: 30 Nov 90 Designer's Address: P.O. Box 1444 City: COLG HARBOR State: WA Zip: 98335

FOR HEALTH DEPARTMENT USE ONLY

Water Supply: V approved Field Area:
hold

ULID: ok for on-site

By: W Date: 12/1/90

hold for sewer
By: Date:
Comments and soil logs:
AT site 11/1/91
JB

FOR OFFICE USE ONLY	DATE	INIT
SUBMITTAL		
HOLD	1/2/91	
APPROVAL/DISAPPROVAL	1/2/91	
MAILED TO BOX	1/2/91	

APPROVED: 3-20-91 BY: T. SEGER


HOLD: 1-18-91 REASON: Data

BY: JB



DISAPPROVED: (date) REASON:
(date)

BY:
(date)


Any person aggrieved by any decision of final order of the Health Officer may within 90 days make written application for appeal to this Department.

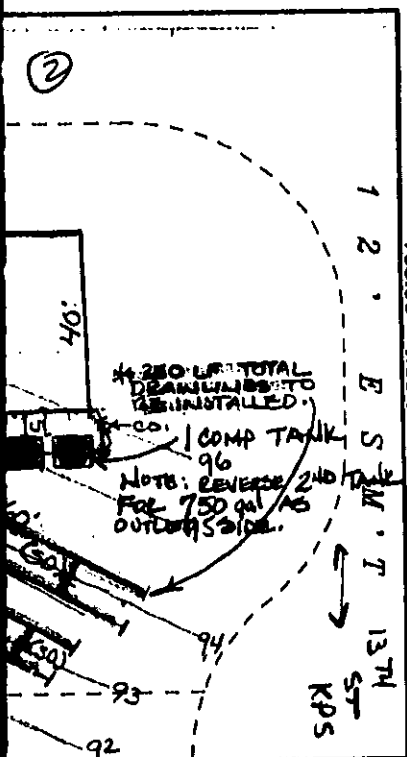

CINITY MAP
TO SCALE

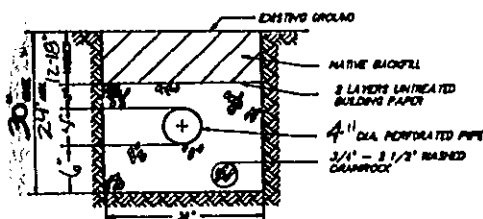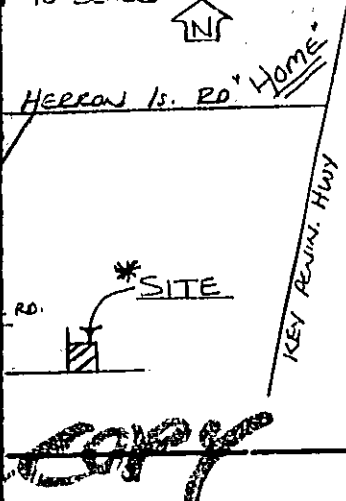

TYPICAL DRAINFIELD TRENCH

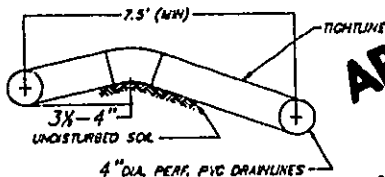

STEP-DOWN DETAIL (S.D.)

APPROVED
MAR 20 1991
TACOMA-PIERCE COUNTY HEALTH DEPT
ENVIRONMENTAL HEALTH DIV.

NOTES:

1. ASCERTAIN LOCATION OF UNDERGROUND UTILITIES BEFORE DIGGING.
2. THIS DESIGN IS BASED UPON 4 BASELINE DAILY USAGE: 150 GAL/BR/DAY. APPLICATION RATE: 20 GAL/SF/DAY.
3. INSTALL 250 LF (MIN) 4" DIA. PERFORATED PVC DRAIN PIPE IN 36" WIDE DRAINFIELD TRENCH.
4. DRAINFIELD LINES MAY BE MOVED AS NEEDED TO ACCOMMODATE EXISTING SLOPE AND TREES. MAINTAIN MIN. 7.5' SPAC.
5. DRAINFIELD LINES ARE TO BE LAID LEVEL.
6. PROVIDE 1250 GAL. 2 COMPARTMENT SEPTIC TANK 4 (1) 2 COMP TANK 96 GAL.
7. ALL SURFACE WINTER RUNOFF FROM PAVED AREAS AND ROOF DRAINS SHALL BE DIRECTED AWAY FROM DRAINFIELD.
8. IF POOR SOILS ARE ENCOUNTERED DURING CONSTRUCTION, NOTIFY ENGINEER BEFORE CONTINUING.
9. MINIMUM GRADING WILL BE DONE IN DRAINFIELD AREA TO PROTECT PERCOLABLE SOIL.
10. NO HEAVY EQUIPMENT OR VEHICULAR TRAFFIC SHALL BE ALLOWED OVER THE DRAINFIELD AREA ONCE CONSTRUCTED.
11. DESIGNED FOR GARBAGE DISPOSAL.
12. NO VERTICAL CUT UNDER 5' SHALL BE ALLOWED WITHIN 15' OF DRAINFIELD AREA. AND NO VERTICAL CUT GREATER THAN 5' SHALL BE ALLOWED WITHIN 25' OF DRAINFIELD AREA.

PAR# 00-20-04-B-015 LOT# 3 SP# 8501070400
CLIENT: FLOYD E. SMITH PH# (619) 948-1963
17728 CHESTNUT ST.
HESTERIA, CA. 92345

SCALE: 1"=30'	SITE: 1317 202ND AVE. KPS	DRAWN BY: <i>JD</i>
DATE: 30 Nov 90		REVISED: 12-11-90
PENINSULA SEPTIC DESIGNS SANDRA R. SMITH P.O. BOX 1444, GIG HARBOR WA 98335		PH# 851-2178
ON SITE SEPTIC DESIGN		JOB NO. 2490