

WV STATE DEPARTMENT OF HEALTH
Office of Environmental Health Services
ENVIRONMENTAL ENGINEERING DIVISION

SW258

WELL COMPLETION REPORT

Date(s) 7/27/98 County Hampshire Permit #: DW-14-99-001
 Town: _____ Area Name/Location Rebel Hill Lot 6
 Well Owner: Charles Conrad Address: HC 71 Box 35F
 Telephone Number: _____ Augusta WV 26704
 Well Driller: B. Mark Smith Address: HC 86 Box 2-A
 Telephone Number: 822-4786 Springfield WV 26763

WELL LOG

DEPTH IN FEET	FORMATIONS: KIND, THICKNESS, AND IF WATER BEARING	REMARKS:
0-40	Soft yellow shale	Type of Well: <u>Home</u> Drilling Method: <u>Air-Hammer</u>
41-99	hard gray shale	Well Diameter: <u>6 1/8"</u> Casing O.D.: <u>6 5/8"</u>
101	water	Well Depth: <u>160'</u> Date Completed: <u>7/27/98</u>
101-139	hard red shale	CASING: Length <u>63</u> Feet Height above ground <u>1</u> Feet
140	water	☒ Steel ☐ Plastic ☐ Cast Iron
141-160	hard gray	Other _____ Type _____

SCREEN☒ None Installed

Type _____ Diameter _____

Slot/Gauge _____ Length _____

Set Between _____ Ft. and _____ Ft.

PUMPING OR BAILING TEST

DETAILS	#1	#2	#3
Static Water Level (Ft. Below Grade)	<u>70</u>		
Pumping Rate (GPM)	<u>40</u>		
Pumping Level (Ft. Below Grade)	<u>130</u>		
Duration of Test (In Hours)	<u>1</u>		
Recovery Time to Static Level (In Hours)	<u>0</u>		

WELL HEAD

Pitless Adapter: Type, Make, Etc. _____

Well Cap: Type, Make, Etc. Standard

Well Seal: Type, Make, Etc. _____

Well Platform: _____

Length _____ Width _____ Thickness _____

Grouting: ☒ Yes ☐ No

All Public Water Supplies must be grouted.

I hereby certify that this well was drilled and constructed under my supervision, in compliance with all requirements of the referenced permit, and that this record is true to the best of my knowledge and belief.

B. Mark Smith #001
 Name B.W. Smith Well Drilling Certification No. _____
 Registered Business Name Brian Mark Smith Date 7/27/98
 Signed _____

SS 177 7/96

INSPECTION TO BE
PRINTED OR TYPED

STATE OF WEST VIRGINIA

Hampshire Co HEALTH DEPARTMENTPermit No.: ST-14-99-005

Tax Map: _____ Parcel #: _____

County Road: _____

County: HAMPSHIRE ON-SITE SEWAGE DISPOSAL SYSTEM
INSPECTION FORMName of Owner: CHARLES CONRAD Installer: Rebel Hill P. AdamsAddress: AC 21 BOX 35F Augusta, WV

Property Location: _____

Type of Facility: _____ Facility is: New Existing () Lot Size: _____ Sq. Ft./AcresDesign Loading in gpd/No. Bedrooms: 3 Source of Water Supply: well

SEWAGE TANK COMPONENT

Capacity in Gallons: 1000 Material: concrete Manufacturer: NolanDistances (in feet) of Tank to: Dwelling: _____ Private ()/Public () Water Source: well Property Line: _____

ON-SITE DISPOSAL SYSTEM

Class I Systems: Standard Soil Absorption Trenches () or Bed () Gravelless Pipe (), Diameter: _____ Inches

Chamber Soil Absorption Trenches () or Bed () 36" H. Capacity

Class II Systems: Pumped/Dosed Soil Absorption Trenches () or Bed () Evapotranspiration Trenches () or Bed ()

Shallow Soil Absorption Trenches () or Bed () Other: _____

No. of Lines: 3 Length (in feet) of Each: 72, 72, 56Width of Trenches: 36 inches/feet Depth to Bottom of Field: 36 inches

If Bed, Dimensions (in Feet): _____ If Chamber System, Name: _____ No. of Units: _____

Approved and Adequate Materials Used? Yes () No () Size Equates to: 1200 Square Feet of Standard Gravel Field.Distances (in feet) of System to: Dwelling: 97 Private ()/Public () Water Source: 100' Property Line: 110'

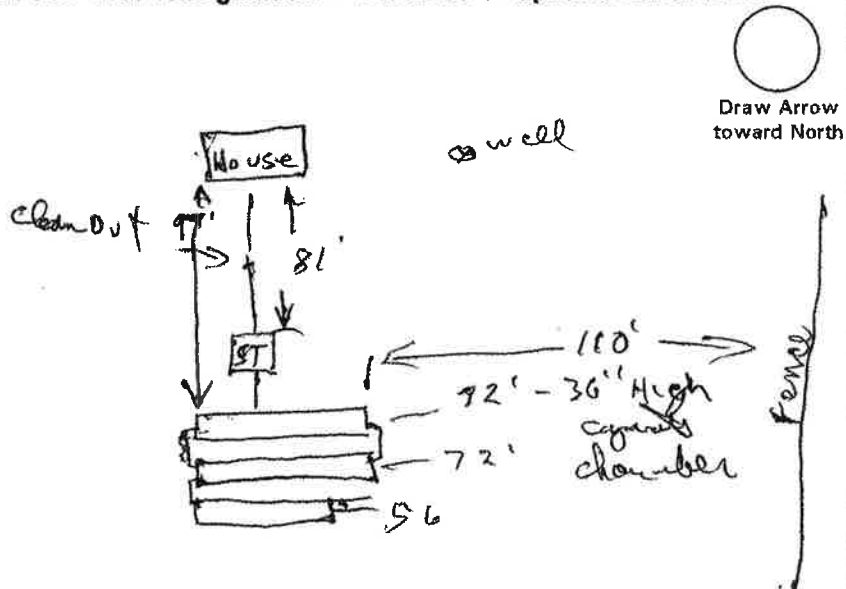
Remarks: _____

An inspection indicates that the sewage disposal system described above **DOES MEET** (), **DOES NOT MEET** (), **CANNOT BE DETERMINED TO MEET** () the minimum standards established by the West Virginia Bureau of Public Health.

To correct a health hazard, modifications to existing systems may be done to improve part of a system. Such modifications may not be able to be designated as a **does meet** system since inadequate information is known.

Although many factors contribute to the successful functioning of a sewage disposal system, this office recommends water conservation and maintaining an even usage of water throughout the week.

Sketch of Installation with Triangulation or Distance to Specific Landmarks:

Visit Date(s): 7-25-98Final Inspection Date: 7-22-98Sanitarian: [Signature]