

SS-177  
Revised 1-71

WEST VIRGINIA  
SEPTIC TANK INSPECTION FORM

Hampshire County Health Department Installation Permit No. ST-14-95-423  
Name of Owner Tim & Jennifer Southley  
Address HC 79 Box 360 Romney, WV 26757  
Property Address Last Mtn. Sub. Lot # 76

DESCRIPTION & NUMBER OF UNITS SERVED

Type Facility Served Home No. Water Closets         
Lot Size 3.57 <sup>acres</sup> sq. ft. Area suitable for sewage disposal installation        sq. ft.  
Source of Water Supply well No. Lavatories         
No. Bedrooms 3 No. Showers or Tubs        No. Baths         
No. Garbage Grinders        No. Automatic Washers       

SEPTIC TANK

Material concrete Length        x Width        x Depth        =        cubic feet  
Liquid Depth        ft. Liquid Capacity 1000 gal.  
Distance to: Dwelling 37' 8 1/2" Water Supply 70' Nearest Property Line 90'

SOIL ABSORPTION SYSTEM

Type Drain Line Material gravelless Trench Width 24 Inches  
Trench Depth 24 Inches Total Absorption area in Trench Bottom 900 sq. ft.  
Diameter of Drain Line 10 Inches Type Filter Media         
No. of Drain Lines 3 Depth Filter Media Under Drain Line        Inches  
Length of Each Line 100, 100, 100, ft. Depth Filter Media Over Drain Line         
Distance of Disposal Field to: (a) Dwelling 95'  
(b) Water Supply 102' (c) Nearest Property Line 40'

An inspection of the septic tank system described herein disclosed that said system (MEETS, DOES NOT MEET) the minimum standards established by the West Virginia State Department of Health.

11-16-95  
Date


[Signature]  
Sanitarian

SKETCH OF SYSTEM TO BE DRAWN ON BACK

Note: Copy of this inspection report must be given to owner and the original filed in the Health Department files. PERMANENT RECORD - DO NOT DESTROY.

PROPLINE

Tim + Jennifer Southerly

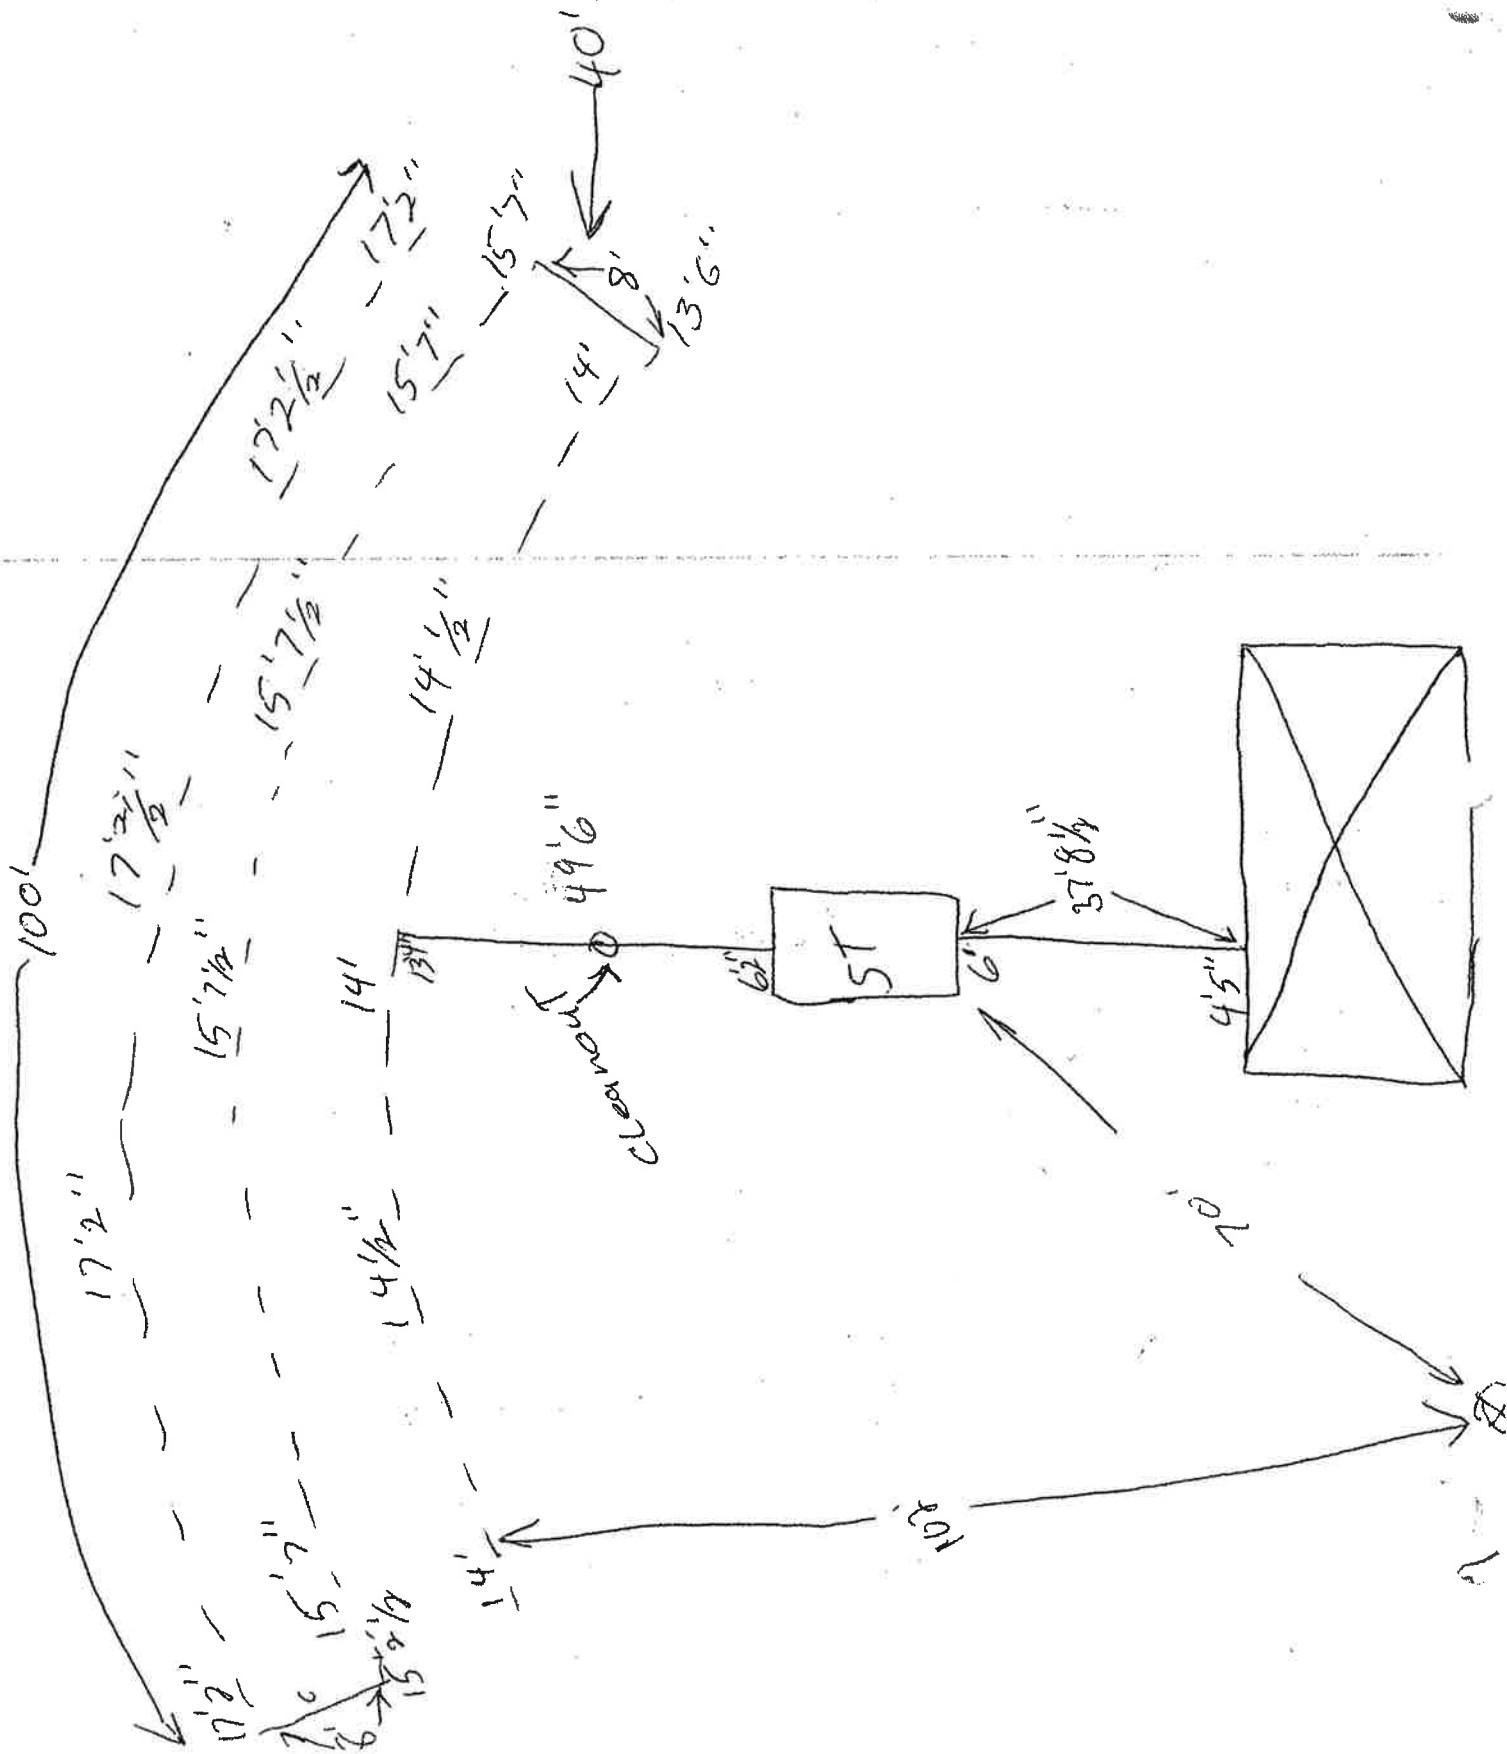

**WV STATE DEPARTMENT OF HEALTH**  
Office of Environmental Health Services  
**ENVIRONMENTAL ENGINEERING DIVISION**

**WELL COMPLETION REPORT**

Date(s) 7-12-95 County Hampshire Permit #: DW-14-06-95-231  
 Town: Romney Area Name/Location Lost Mt. Sub  
 Well Owner: Tim Southerly Address: HC 74 Box 73B  
 Telephone Number: 304-822-5719 Romney, W.V. 26157  
 Well Driller: Randal C Miller Address: Rt #1 Box 186  
 Telephone Number: 304-738-3266 Ridgeley, W.V. 26753

**WELL LOG**

DEPTH IN FEET	FORMATIONS: KIND, THICKNESS, AND IF WATER BEARING	REMARKS:
0-9'	RED SLATE (UNCONSOLIDATED)	Pressure Grouted
9'	BLUE SANDSTONE (BEDROCK)	Type of Well: <u>DW</u> Drilling Method: <u>AIR ROTARY HAMMER</u>
20'	BLUE SANDSTONE (CONSOLIDATED)	Well Diameter: <u>6 5/8"</u> Casing O.D.: <u>6 5/8"</u>
	Set Casing	Well Depth: <u>355'</u> Date Completed: <u>7-12-95</u>
182'	BLUE SANDSTONE (Water 2 gpm)	CASING: Length <u>21</u> Feet Height above ground <u>1</u> Feet
355'	BLUE SANDSTONE (CONSOLIDATED)	<input checked="" type="checkbox"/> Steel <input type="checkbox"/> Plastic <input type="checkbox"/> Cast Iron
	Stopped Drilling	Other _____ Type _____
		<b>SCREEN</b>
		<input checked="" type="checkbox"/> None Installed
		Type _____ Diameter _____
		Slot/Gauge _____ Length _____
		Set Between _____ Ft. and _____ Ft.

**PUMPING OR BAILING TEST**

DETAILS	#1	#2	#3
Static Water Level (Ft. Below Grade)	<u>120</u>		
Pumping Rate (GPM)	<u>2 1/2</u>		
Pumping Level (Ft. Below Grade)	<u>345</u>		
Duration of Test (In Hours)	<u>2</u>		
Recovery Time to Static Level (In Hours)	<u>6</u>		

**WELL HEAD**

Pitless Adapter: Type, Make, Etc. \_\_\_\_\_  
 Well Cap: Type, Make, Etc. Royer-Conduit Type  
 Well Seal: Type, Make, Etc. \_\_\_\_\_  
 Well Platform: \_\_\_\_\_  
 Length \_\_\_\_\_ Width \_\_\_\_\_ Thickness \_\_\_\_\_  
 Grouting: ☒ Yes ☐ No  
 All Public Water Supplies must be grouted.

I hereby certify that this well was drilled and constructed under my supervision, in compliance with all requirements of the referenced permit, and that this record is true to the best of my knowledge and belief.

Randal C. Miller 432  
 Name Certification No.  
Miller Bros. Drilling  
 Registered Business Name  
Randal C. Miller 7-12-95  
 Signed Date