

SS-177
Revised 1-71WEST VIRGINIA
SEPTIC TANK INSPECTION FORM

Hampshire County Health Department Installation Permit No. ST-14-76-134
 Name of Owner BOTT, FLOYD
 Address RID, W.VA.
 Property Address 2 MILES NORTH OF RID ON LEFT OF No. RIVER Rd.

DESCRIPTION & NUMBER OF UNITS SERVED

Type Facility Served EXISTING HOUSE No. Water Closets 2
 Lot Size 225-ACRES sq. ft. Area suitable for sewage disposal installation 20,000 sq. ft.
 Source of Water Supply DRILLED WELL No. Lavatories 2
 No. Bedrooms 3 No. Showers or Tubs 1 No. Baths 1 1/2
 No. Garbage Grinders 0 No. Automatic Washers 1

SEPTIC TANK

Material Concrete Length _____ x Width _____ x Depth _____ = _____ cubic feet
 Liquid Depth _____ ft. Liquid Capacity 1,000 gal.
 Distance to: Dwelling 60' Water Supply 115' Nearest Property Line 70'

SOIL ABSORPTION SYSTEM

Type Drain Line Material Plastic Trench Width 24 Inches
 Trench Depth 30 Inches Total Absorption area in Trench Bottom 640 sq. ft.
 Diameter of Drain Line 4 Inches Type Filter Media GRAVEL
 No. of Drain Lines 4 Depth Filter Media Under Drain Line 6 Inches
 Length of Each Line 80', 80', 80', 80' ft. Depth Filter Media Over Drain Line 2 in
 Distance of Disposal Field to: (a) Dwelling 75'
 (b) Water Supply 120' (c) Nearest Property Line 40'

An inspection of the septic tank system described herein disclosed that said system (MEETS, ~~DOES NOT MEET~~) the minimum standards established by the West Virginia State Department of Health.


July 22, 1976
 Date

C. E. Bright
 Sanitarian

SKETCH OF SYSTEM TO BE DRAWN ON BACK

Copy of this inspection report must be given to owner and the original filed in the Health Department files. PERMANENT RECORD - DO NOT DESTROY.

Floyd Batt

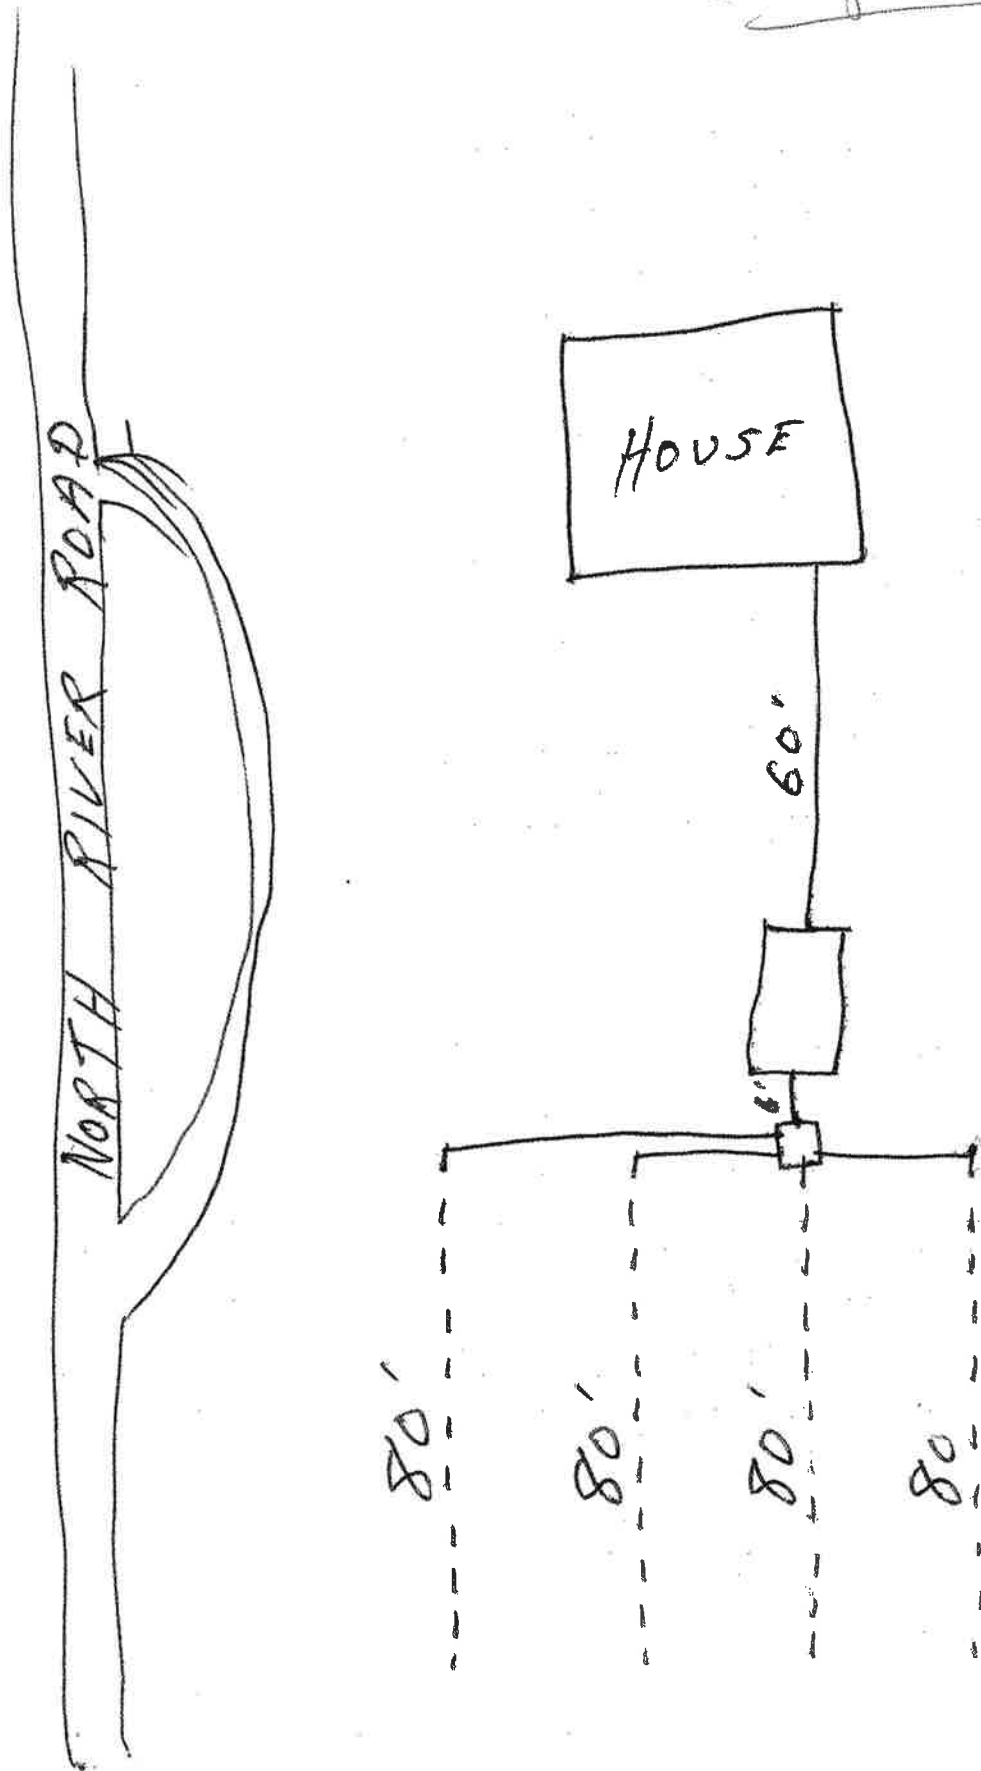

~~N~~