

5 ml are

BELL COUNTY PUBLIC HEALTH DISTRICT

Temple and Killeen

PERMIT TO INSTALL A SEPTIC TANK SYSTEM

Permit No. **T 6451**

Receipt No. **25244**

Flood Plain No. **NA.**

Zip **76569** B **2**

Location **East Bell** St. Address **9431 + 9433 E Hwy 190, Rogers**

Legal Description: Survey **Marino Moreno** Abstract No. **14** Vol. _____ Page _____ Blk. _____ Lot _____ Sec. _____

Issued By: **J. Mann** Date Issued: **2-3-2005** This Permit Expires: **2-3-2006**

Owner **Russell & Katherine Rice** Address **9433 E. Hwy 190, Rogers** Phone **983-1943**

Installer **Frei Enterprises** Address **11821 Hwy 53, Temple** Phone **985-2243**

Signature **X. Kathleen Melfee** Amount Paid **\$100.00 CK# 1010**

Treatment: Standard _____ Size Required _____ Size Installed _____

Aerobic **Existing Jet** Size Required **500** Serial # **Existing Jet 500.**

Disposal: Type **Surface Spray**

Area Required **8478** Area Installed _____

No. of Bedrooms **5** GPD **420** Soil Type **IV**

M/C _____ Affidavit _____ License No. **3721** X **Bary Mc** Installer

Remarks: **84.84 acres**


Existing Permit T3071 installed 3-6-98.

Date **2-4-05**


Michael Johns Inspector

Drawing of System: (Not to scale)

STRIP MAP

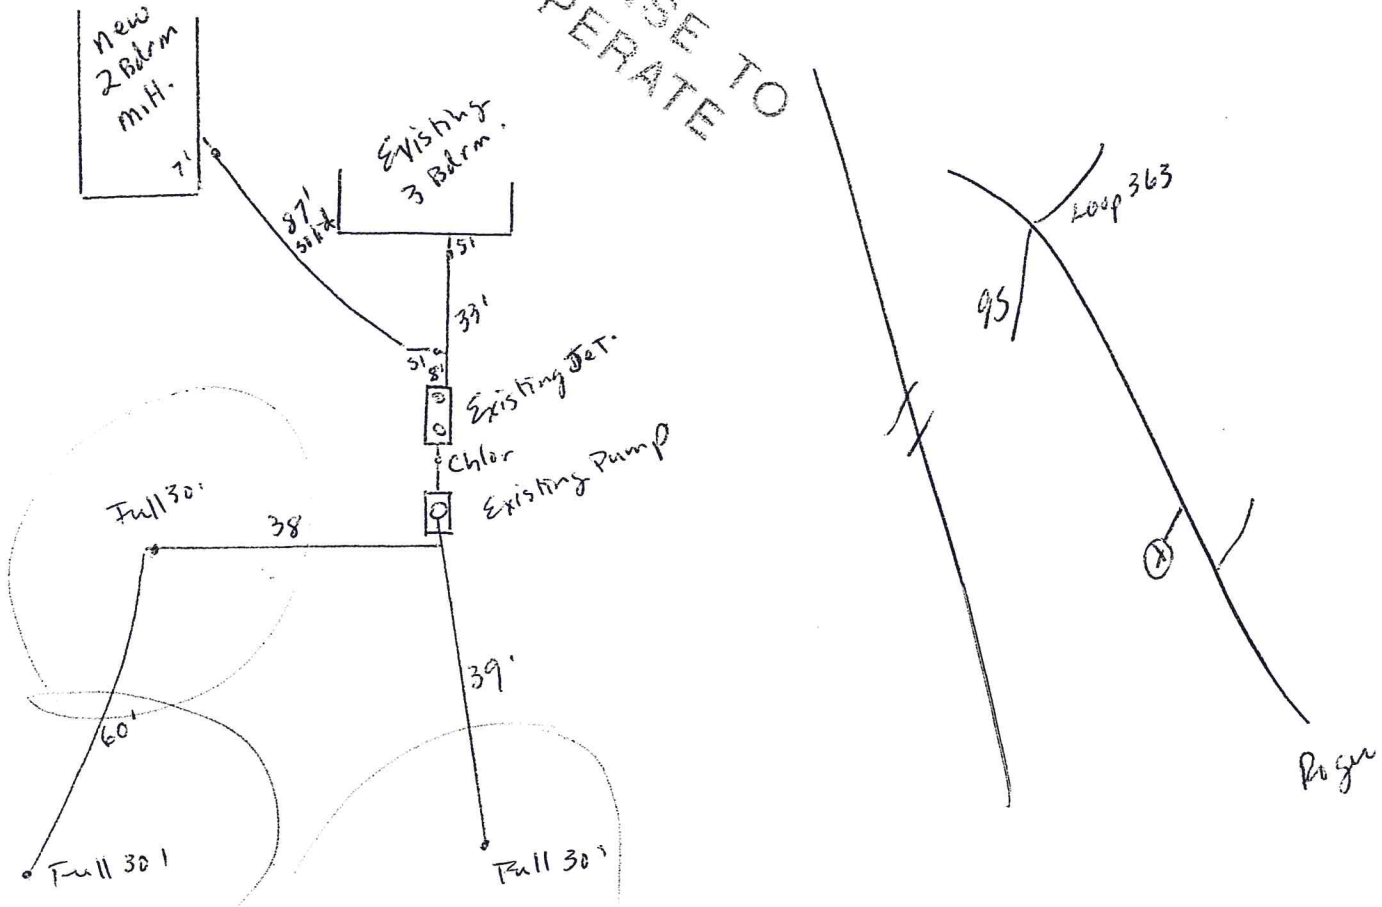

No other property lines within 500' from any system component.

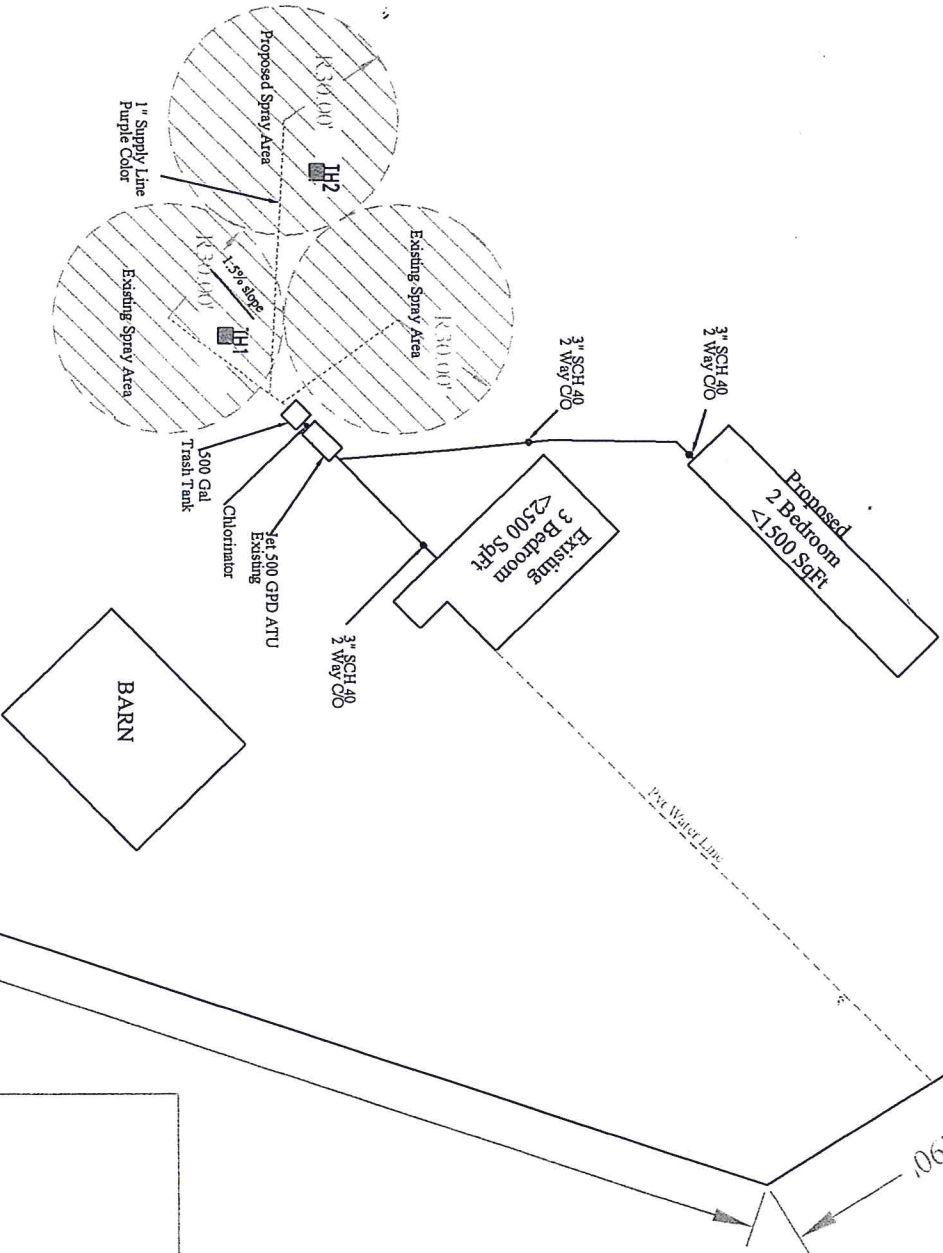

9433 E. HWY 36

Overview Det

Owner:

Legal Desc:

9433 E Hwy 190 Rogers
84.843 Ac Maximo More

Scale: 1" = 50'

ZBR231