

## Pamiico County Health Department

203 North Street PO Box 306 Bayboro, NC 28529 Tel: (252) 745-5111 Fax: (252) 745-7684

RE: Parcel ID: C07-24

Dear Sir or Madam:

The installation of the system indicated on the enclosed permit requires that an Authorization to Construct be paid for and obtained before any installation can take place. This authorization is also required before any building permits can be obtained. If the site requires modifications (i.e. drainage, mound construction, etc.), then the required site improvements must be done and inspected prior to the issuance of the authorization to construct. The authorization to construct fee for this system is \$100.00 at this time. This fee is subject to change at the discretion of the Board of Health and the Board of Commissioners. Buckesed you will find an application for an Authorization to Construct and a list of the Pamlico County Registered Installers. The person or company that will be installing your system must be registered with Pamlico County and be a licensed installer (with the appropriate grade level) in the State of North Carolina. Please fill out the Authorization to Construct and pay the fee when you are ready to install your system or prior to obtaining any other required permits.

In addition there will also be an installation inspection fee required to be paid before the issuance of the final operation permit. This permit fee must be paid and all other conditions met prior to the operation permit being released by this department. The fee at this time is \$100.00 and may be paid in conjunction with the authorization to construct.


Thank you for your cooperation in acquiring the Authorization to Construct/Operation Permit. If you have any questions feel free to contact us at 745-5634.

Sincerely,

Bryan C. Harris, REHS

Environmental Health Coordinator

Tayan C. Havris, KEHS

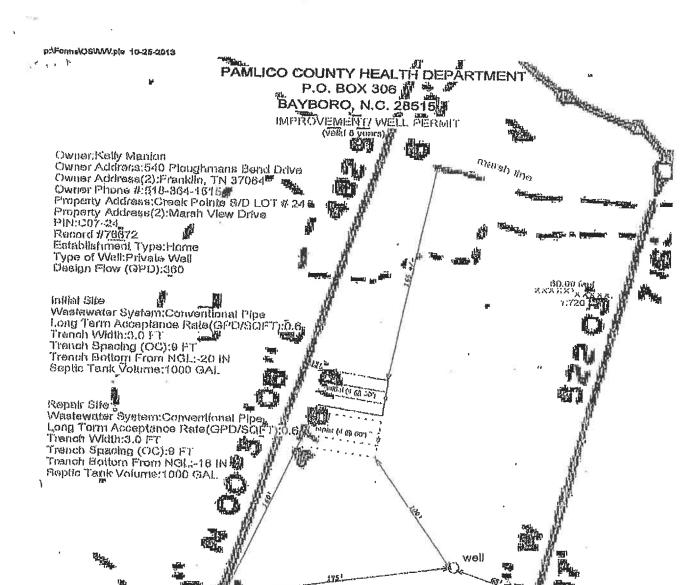

Install 4 lines (3' x 50') conventional rock trenches for Initial and free repair. Lines should be 18-20 inches deep maximum. Well location is shown on permit. Well must rosintall 100' S/B from system and 25' S/B from say building foundation. Contact HD if you have any questions regarding this permit. Telephone (252) 746-5634

AN AUTHORIZATION TO CONSTRUCT MUST BE OBTAINED AND ALL FEES PAID PRIOR TO WASTEWATER SYSTEM INSTALLATION

THE PAMLICO COUNTY HEALTH DEPARTMENT RESERVES THE RIGHT TO REVOKE THIS PERMIT IF THE SITE IS ALTERED, INTENDED USE IS CHANGED, OR ANY INFORMATION IS FALSIFIED.

ANY CHANGES TO THIS PERMIT WILL REQUIRE A REDESIGN PERMIT AND SUBSEQUENT FEE.

Prepared with Quikplaterosz sollware by byang berds