

SS 177 7/96

INSPECTION TO BE
PRINTED OR TYPED

STATE OF WEST VIRGINIA

HEALTH DEPARTMENT

ON-SITE SEWAGE DISPOSAL SYSTEM

INSPECTION FORM

Permit No.: ST-14-04-62Tax Map: 10 Parcel #: 0078

County Road: _____

County: AMPSHIREName of Owner: ANITA GALLIAKInstaller: JOE R. RAYAddress: NC 64 BOX 2090Property Location: FORT LEISURE LOT #5 THREE CHURCHES, WV 26257Type of Facility: HOUSE Facility is: New (☒) Existing ()Design Loading in gpd/No. Bedrooms: 23K Source of Water Supply: Well Lot Size: 2.12 Sq. Ft./Acres

SEWAGE TANK COMPONENT

Capacity in Gallons: 1000 Material: Concrete Manufacturer: VolvoDistance (in feet) of Tank to: Dwelling: 10+ Private (☒) Public () Water Source: 10+ Property Line: 10+

to be

ON-SITE DISPOSAL SYSTEM

to be

Class I Systems: Standard Soil Absorption Trenches () or Bed () Gravelless Pipe (), Diameter: _____ Inches

Class II Systems: Chamber Soil Absorption Trenches (☒) or Bed ()
Pumped/Dosed Soil Absorption Trenches () or Bed () Evapotranspiration Trenches () or Bed ()
Shallow Soil Absorption Trenches () or Bed () Other: _____No of Lines: 3 Length (in feet) of Each: 80 , 80 , 80Width of Trenches: 36 inches/feet Depth to Bottom of Field: 24-36 inches

If Bed, Dimensions (in Feet): _____ If Chamber System, Name: _____, No. of Units: _____

Approved and Adequate Materials Used? Yes (☒) No () Size Equates to 210 Square Feet of Standard Gravel Field.Distance (in feet) of System to: Dwelling: 10+ Private (☒) Public () Water Source: 10+ Property Line: 10+Remarks: to be to be

An inspection indicates that the sewage disposal system described above **DOES MEET** (☒) **DOES NOT MEET** (), **CANNOT BE DETERMINED TO MEET** () the minimum standards established by the West Virginia Bureau of Public Health.

To correct a health hazard, modifications to existing systems may be done to improve part of a system. Such modifications may not be able to be designated as a **does meet** system since adequate information is known.

Although many factors contribute to the successful functioning of a sewage disposal system, this office recommends water conservation and maintaining an even usage of water throughout the week.

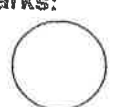
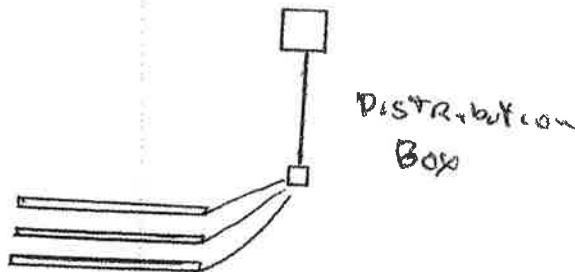
Sketch of Installation with Triangulation or Distance to Specific Landmarks:

10-15-03

NO HOUSE

NO WELL

NOT TO SCALE


Draw Arrow
toward North
Distribution
Box

Installation Date(s) 8-27-03
Final Inspection Date: 10-15-03

Sanitarian: J. Kunder