


BEARINGS ARE BASED ON THE
TEXAS STATE PLANE COORDINATE SYSTEM
OF 1983, TEXAS CENTRAL ZONE

LINE	BEARING	DISTANCE			
L1	S 30°02'20" E	62.49			
L2	S 39°12'50" E	63.48			
CURVE					
CI	2804.29	042.05	235.87°	117.87°	N 62°17'12" E 235.75'
CD	2904.70	0715.07	11.04°	8.52°	N 59°30'08" E 13.94'

BEARINGS ARE BASED ON THE
TEXAS STATE PLANE COORDINATE SYSTEM
OF 1983, TEXAS CENTRAL ZONE

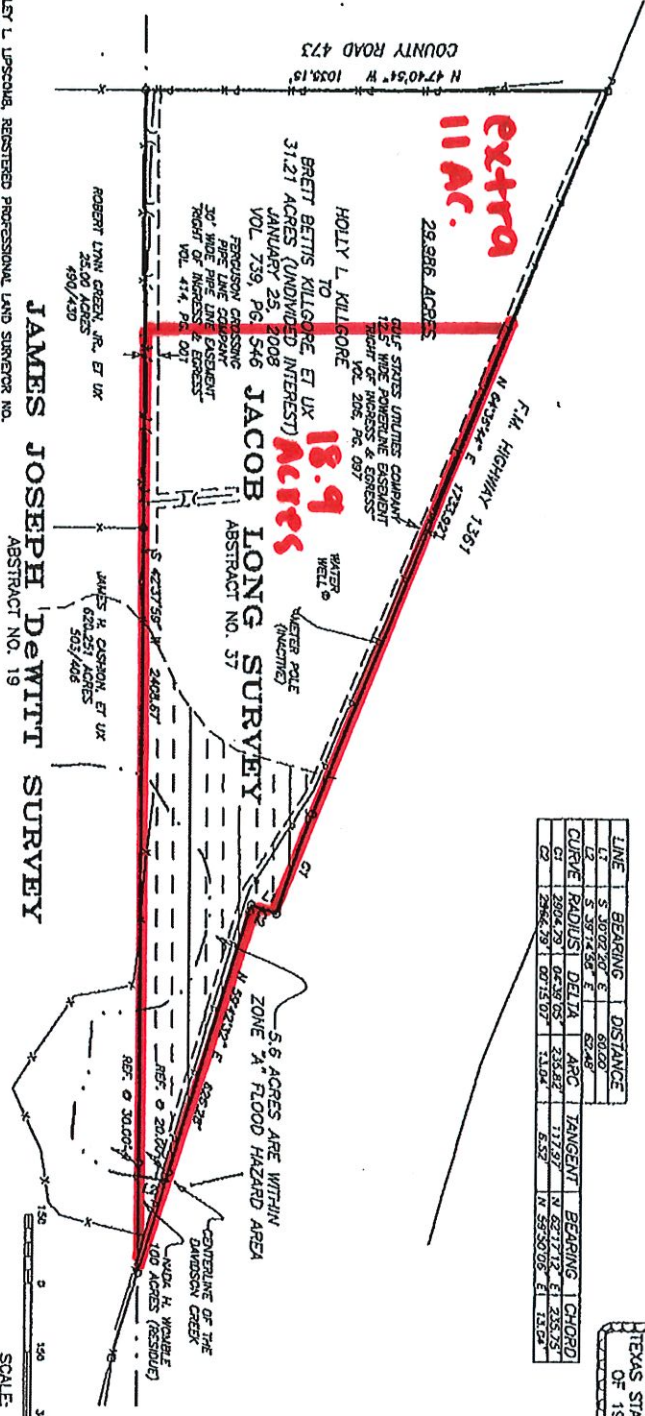

LEGEND

- X- BARBED WIRE FENCE
- IRON ROD FOUND
- IRON ROD SET
- Δ SURVEY POINT

1 OVERHEAD POWERLINE

2 UNDERGROUND PIPELINE

SCALE- 1" = 300 FEET

JAMES JOSEPH DeWITT SURVEY
AND SURETOR NO. ABSTRACT NO. 19

1. BRODALE LUGSBOROUGH, RESTRICTED PROFESSIONAL LAND SURVEYOR NO. 5952 IN THE STATE OF TEXAS, DO HEREBY CERTIFY TO THE TITLE AGENCY, UNDERWRITER, LENDER, MORTGAGE CO. AND/OR PURCHASER THAT THIS PROPERTY IS NOT SUBJECT TO ANY OF THE EASES, RIGHTS, OR INTERESTS ATTACHED TO THIS TRACT, AND CONSEQUENTLY, THE EFFECTS OF THE EASES AND RIGHTS ATTACHED TO THIS TRACT, THE SITE, LOCATION AND TYPE OF BUILDINGS AND IMPROVEMENTS ARE AS SHOWN THERE ARE NO APPARENT DISCREPANCIES, CONFLICTS, ENCROACHMENTS, OVERLAPPING OF IMPROVEMENTS, VISIBLE ACCESS TO AND FROM A DEDICATED ROADWAY, AND 5.6 ACRES ARE WITHIN ZONE A OF THE FLOOD HAZARD AREA, ACCORDING TO FLOOD RISK MAP COUNCILMAN NO. 48189 AS SHOWN ON PAGES 0420 TO BURESSON COUNTY, TEXAS, DATED JANUARY 25, 2011; THIS PROFESSIONAL SERVICE COMPLEDES THE DUTY OF A LAND SURVEYOR IN TEXAS, AND THERE ARE NO OTHER SPECIFICATIONS FOR A CATEGORY 1A, CONDITION IV, SURVEY.

EVEN UNDER MY HAND AND SEAL THIS 10TH DAY OF FEBRUARY, 2011.



BRADLEY UPSSOMB, RPLS

	
SURVEYING, INC. 1311 WEST CAMERON P.O. BOX 1445 ROCKDALE, TX. 76567	
29.985 ACRES JACOB LONG SURVEY ABSTRACT NO. 37 BURLESON COUNTY, TEXAS	
Completion Date: 2/10/11	Drawn by: BL
Scale: 1" = 300' PROJECT NO. S10-047	Surveyed by: KC/LS Checked by: BL

An aerial photograph of a wooded area with several property boundaries outlined in red. A large, irregularly shaped parcel is outlined in a thick red line. Within this parcel, the text "extra 11 AC." is written in red. Another area within the parcel is labeled "18.9 Acres" in red. The parcel is divided into several sections by red lines. One section is labeled "A-37 LOWE, JJ" in white. Another section is labeled "A-19 DEWITT, JJ" in white. The parcel is surrounded by other land parcels, some of which are labeled with numbers: 20201, 20229, 20239, 20257, 20210, 20221, 20217, 20231, 20223, 20215, 20202, 20234, 33328, and 28333. A road or path runs diagonally across the top of the image. A blue line runs along the left side of the main parcel. A white line runs diagonally across the bottom of the image.

Parcels
Abstracts

Disclaimer: This product is for informational purposes only and has not been prepared for or be suitable for legal, engineering, or surveying purposes. It does not represent an on-the-ground survey and represents only the approximate relative location of boundaries.

Source: Esri, DigitalGlobe, GeoEye, Earthstar Geographics, CNES/Airbus DS, USDA, USGS, AeroGRID, IGN, and the GIS User Community

Burleson County Appraisal District: BIS Consulting - www.bisconsultants.com
Esri, HERE | USDA FSA, DigitalGlobe, GeoEye |