

WV STATE DEPARTMENT OF HEALTH
Office of Environmental Health Services
ENVIRONMENTAL ENGINEERING DIVISION

Capon Woods Resort Lot 4
per 11-13-98

SW258

WELL COMPLETION REPORT

Date(s) 10/22/98-10/22/99 County Hampshire Permit #: DW-14-99-120
Town: _____ Area Name/Location _____
Well Owner: Joseph Bradshaw Address: 2089 Rosedale Road
Telephone Number: 304-263-1646 Martinsburg West Va. 25401
Well Driller: Payne Well Drilling, Inc. Address: P.O. Box 160
Telephone Number: 540-662-4957 Stephenson, Va. 22656

WELL LOG

DEPTH IN FEET	FORMATIONS: KIND, THICKNESS, AND IF WATER BEARING	REMARKS:
0- 70	OVERBURDEN	Type of Well: _____ Drilling Method: <u>Rotary Air</u>
70	BEDROCK	Well Diameter: <u>6 5/8</u> Casing O.D.: <u>6 1/8</u>
70-190	SHALE	Well Depth: <u>200 feet</u> Date Completed: <u>11/4/98</u>
190-191	WATER	CASING: Length <u>80</u> Feet Height above ground <u>1 1/2</u> Feet
191-200	SHALE	☒ Steel ☐ Plastic ☐ Cast Iron
		Other _____ Type _____
		SCREEN
		☐ None Installed <u>N/A</u>
		Type _____ Diameter _____
		Slot/Gauge _____ Length _____
		Set Between _____ Ft. and _____ Ft.

PUMPING OR BAILING TEST

DETAILS	#1	#2	#3
Static Water Level (Ft. Below Grade)	<u>35</u>		
Pumping Rate (GPM)	<u>25</u>		
Pumping Level (Ft Below Grade)			
Duration of Test (In Hours)			
Recovery Time to Static Level (In Hours)			

WELL HEAD**DID NOT INSTALL PUMP**

Pitless Adapter: Type, Make, Etc. _____
Well Cap: Type, Make, Etc. _____
Well Seal: Type, Make, Etc. _____
Well Platform:
Length _____ Width _____ Thickness _____
Grouting: ☒ Yes ☐ No
All Public Water Supplies must be grouted.

I hereby certify that this well was drilled and constructed under my supervision, in compliance with all requirements of the referenced permit, and that this record is true to the best of my knowledge and belief.

GARY L. PAYNE 006
Name PAYNE WELL DRILLING, INC. Certification No. _____
Registered Business Name Gary L. Payne 11/4/98
Signed _____ Date _____

SS 177 7/96

INSPECTION TO BE
PRINTED OR TYPED

STATE OF WEST VIRGINIA

Hampshire HEALTH DEPARTMENTPermit No.: ST-14-99-125County: HampshireON-SITE SEWAGE DISPOSAL SYSTEM
INSPECTION FORM

Tax Map: _____ Parcel #: _____

County Road: _____

Name of Owner: Joseph Bradshaw Installer: GARY HAINES
 Address: 2029 Rosedale Rd Martinsburg, WV 25401
 Property Location: Cypress Woods Resort Lot #40
 Type of Facility: House Facility is: New () Existing (X) Lot Size: 3 Sq.-Ft./Acres
 Design Loading in gpd/No. Bedrooms: 2 BR Source of Water Supply: well

SEWAGE TANK COMPONENT

Capacity in Gallons: 1000 Material: concrete Manufacturer: data S+S
 Distances (in feet) of Tank to: Dwelling: 12 Private (X)/Public () Water Source: 69' Property Line: _____

ON-SITE DISPOSAL SYSTEM

Class I Systems: Standard Soil Absorption Trenches () or Bed () Gravelless Pipe (X) Diameter: 10 Inches
 Chamber Soil Absorption Trenches () or Bed ()
 Class II Systems: Pumped/Dosed Soil Absorption Trenches () or Bed () Evapotranspiration Trenches () or Bed ()
 Shallow Soil Absorption Trenches () or Bed () Other: _____

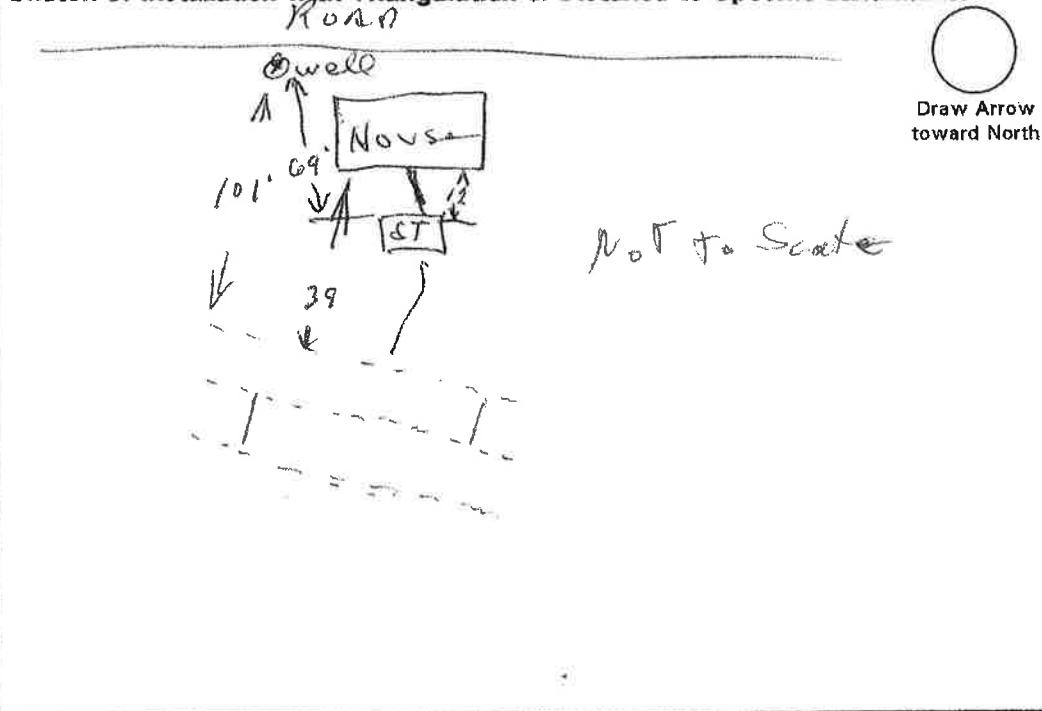
No. of Lines: 3 Length (in feet) of Each: 100, 100, 100
 Width of Trenches: 24 inches/feet Depth to Bottom of Field: 24.36 inches
 If Bed, Dimensions (in Feet): _____ If Chamber System, Name: _____, No. of Units: _____
 Approved and Adequate Materials Used? Yes (X) No () Size Equates to: 900 Square Feet of Standard Gravel Field.
 Distances (in feet) of System to: Dwelling: 39 Private (X)/Public () Water Source: 101 Property Line: _____
 Remarks: _____

An inspection indicates that the sewage disposal system described above
DOES MEET (X)
DOES NOT MEET (),
CANNOT BE DETERMINED TO MEET () the minimum standards established by the West Virginia Bureau of Public Health.

To correct a health hazard, modifications to existing systems may be done to improve part of a system. Such modifications may not be able to be designated as a does meet system since inadequate information is known.

Although many factors contribute to the successful functioning of a sewage disposal system, this office recommends water conservation and maintaining an even usage of water throughout the week.

Sketch of Installation with Triangulation or Distance to Specific Landmarks:

Visit Date(s): 11-19-98Final Inspection Date: 12-21-98Sanitarian: Joe Kuntz